


T. 2S., R. 45E., W. M.

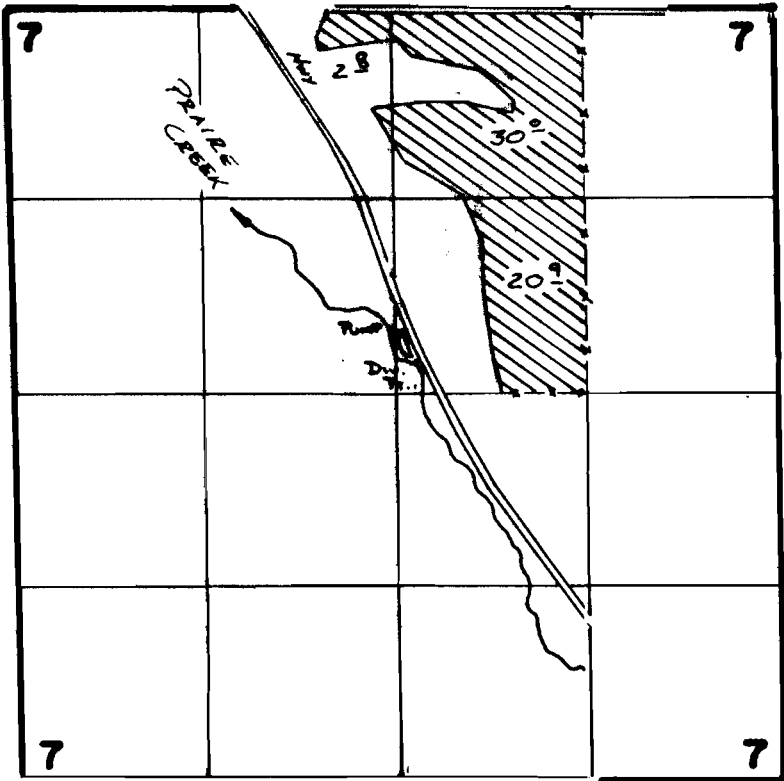

SCALE 1" = 1320'

Div. Pt. Loc: 170' N. & 170' E FROM CENTER COR. SEC 7

FINAL PROOF SURVEY
UNDER

Application No. **56182** Permit No. **42261**.....
IN NAME OF

.....**DICK C. INGLE**.....

Surveyed 19....., by