


T.13&14 S., R. 4W., W.M.

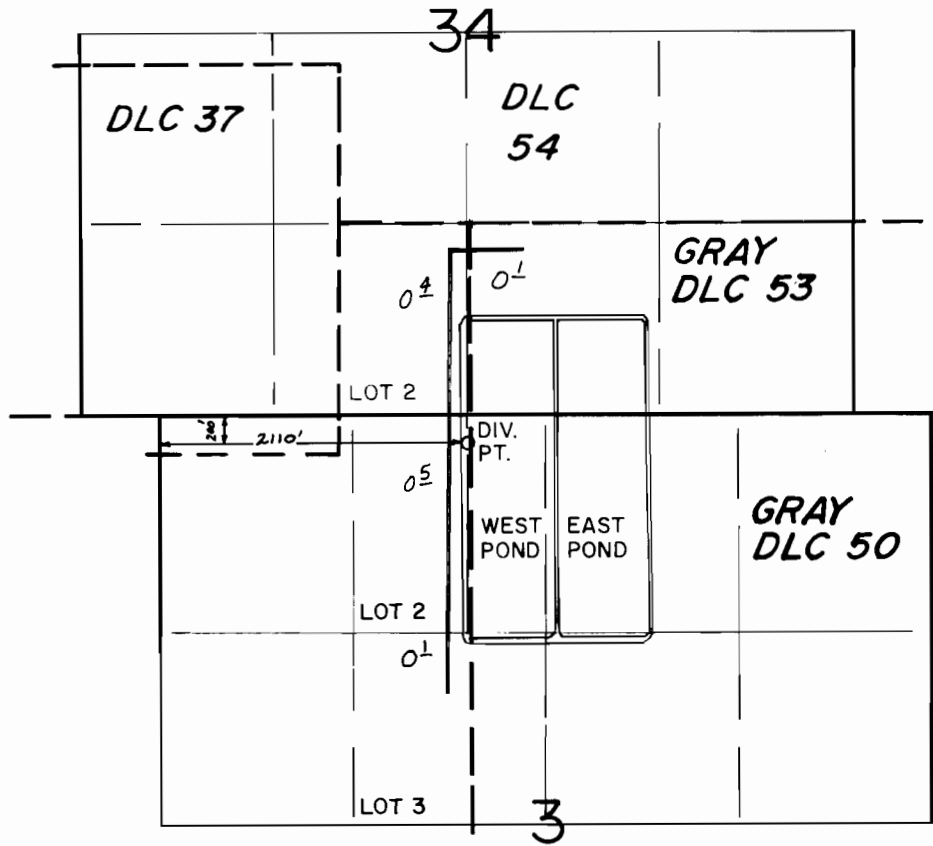

SCALE: 1" = 1320'

FINAL PROOF SURVEY
UNDER

Application No. 56185... Permit No. 43029...
IN NAME OF

JAMES RIVER DIXIE NORTHERN, INC.

Surveyed JULY 12, 1984, by L.M. TOLL