


T. 9S. R. 45E. W. M.

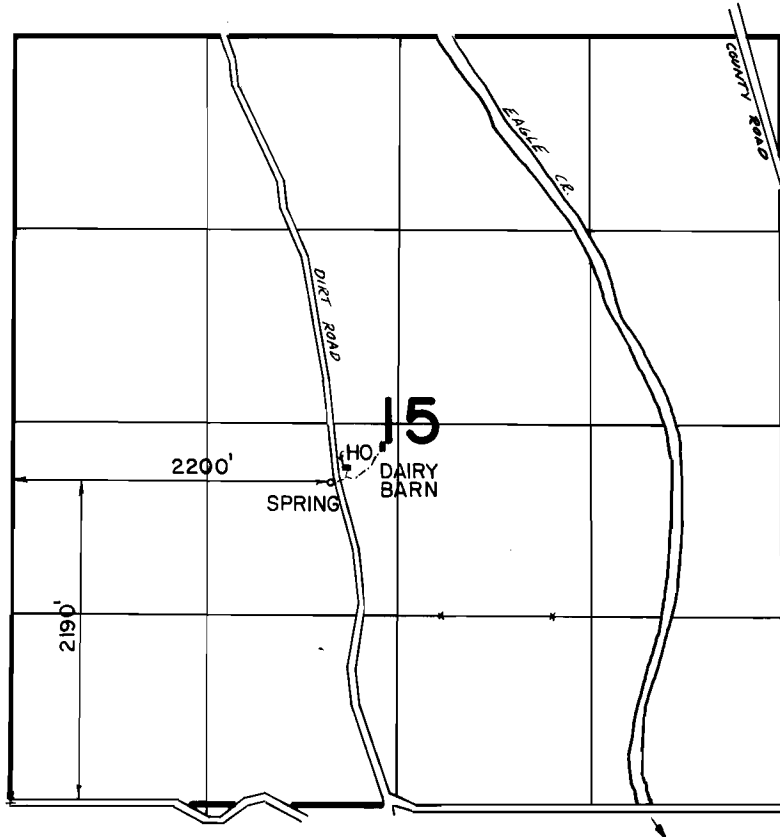

**FINAL PROOF SURVEY**  
UNDER

Application No. 56216 Permit No. 42264  
IN NAME OF

JOHN ALBERT CHANDLER

Surveyed 11-15 1978, by R. BARWIN

BBB-2kk-95  
PTS-1978-P.E.  
BBB-EKK-112  
REV. 8-3-88 V.L.C.