


T.28S.,R.4W.,W.M.

SECTION 28

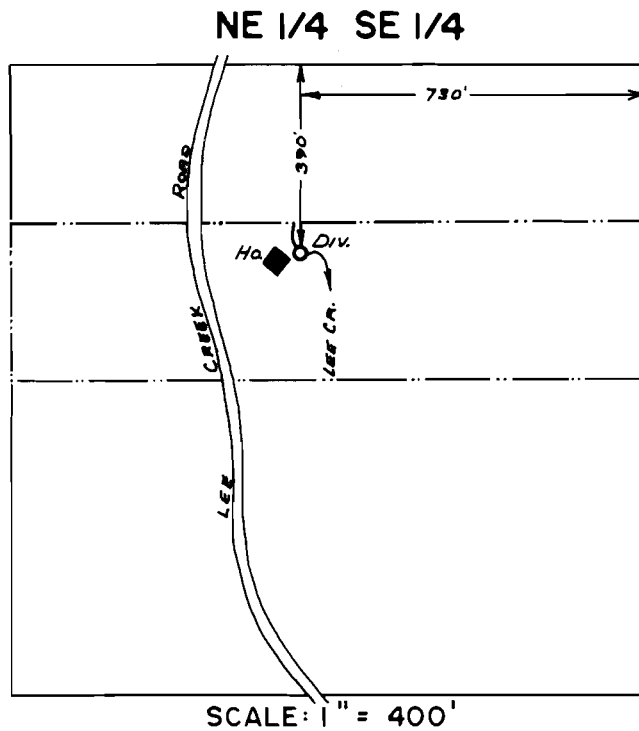

FINAL PROOF SURVEY
UNDER

Application No. .56524. Permit No. .42741.....
IN NAME OF

.....**CHARLES E. WILLARD**.....

Surveyed .Aug..18.. 19.81., by ...L. TOLL.....