


T. 35 S., R. 7 W., W. M.

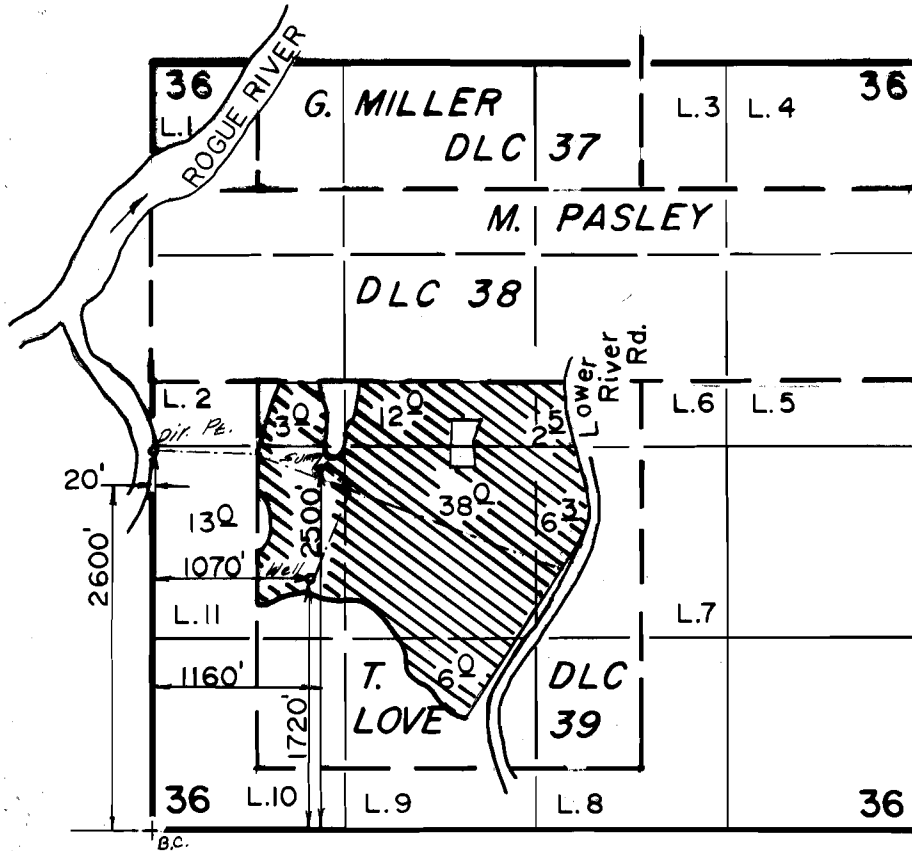

Scale: 1" = 1320'

FINAL PROOF SURVEY UNDER

G-6968 G-6479

Application No. 56666 Permit No. 42054..

IN NAME OF

.....ROBERT HOELLRICH.....

Surveyed OCT. 8... 1987., by B. S. JAMES....