


T.8S.,R.46E.,W.M.

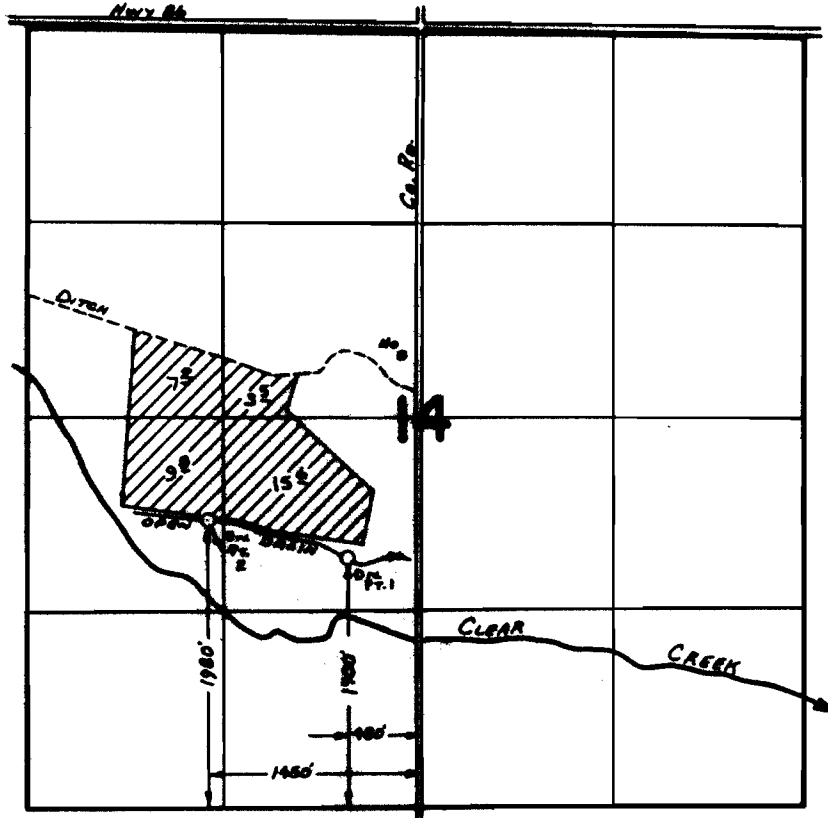

SCALE: 1" = 1320'

FINAL PROOF SURVEY UNDER

Application No. ~~56744~~ Permit No. ~~42797~~.....
IN NAME OF

.....JERRY DELCURTO.....

Surveyed Aug. 28, 1985, by L. M. TOLL.....