


T. 39 S., R. 2 W., W. M.

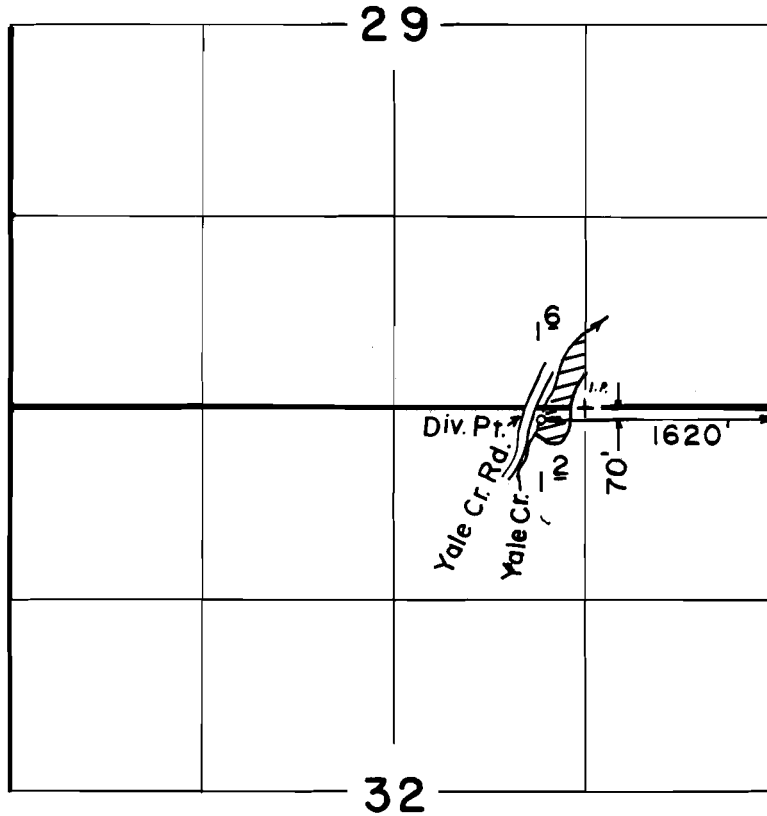

Scale: 1" = 1320'

FINAL PROOF SURVEY
UNDER

Application No. 56883 Permit No. 42660
IN NAME OF

GILFORD E. MEADOR

Surveyed JUL 9 19.86, by B. S. JAMES