


T.15S.,R.5W.,W.M.

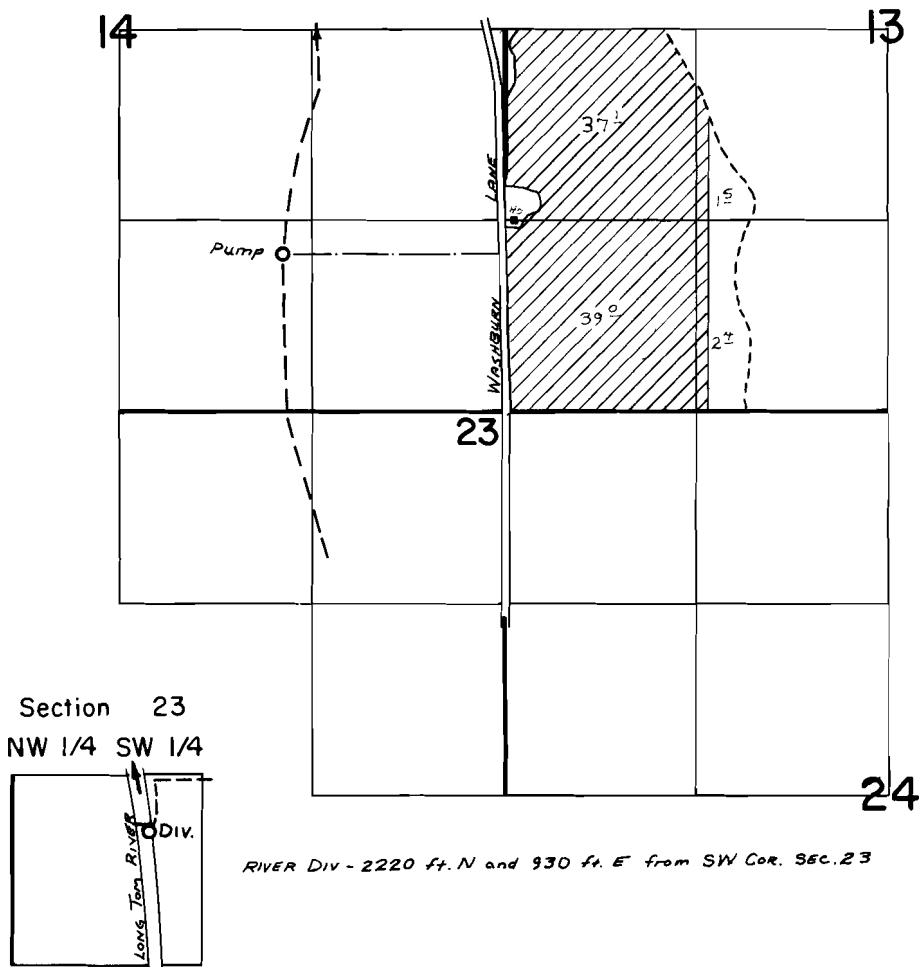

# FINAL PROOF SURVEY

## UNDER

Application No. 56939 Permit No. 42771.....  
IN NAME OF

KELLY R. & JANET J. LOVELACE

Surveyed Aug. 2 1982, by L. M. TOLL