


T. 7S., R. 38E., W. M.

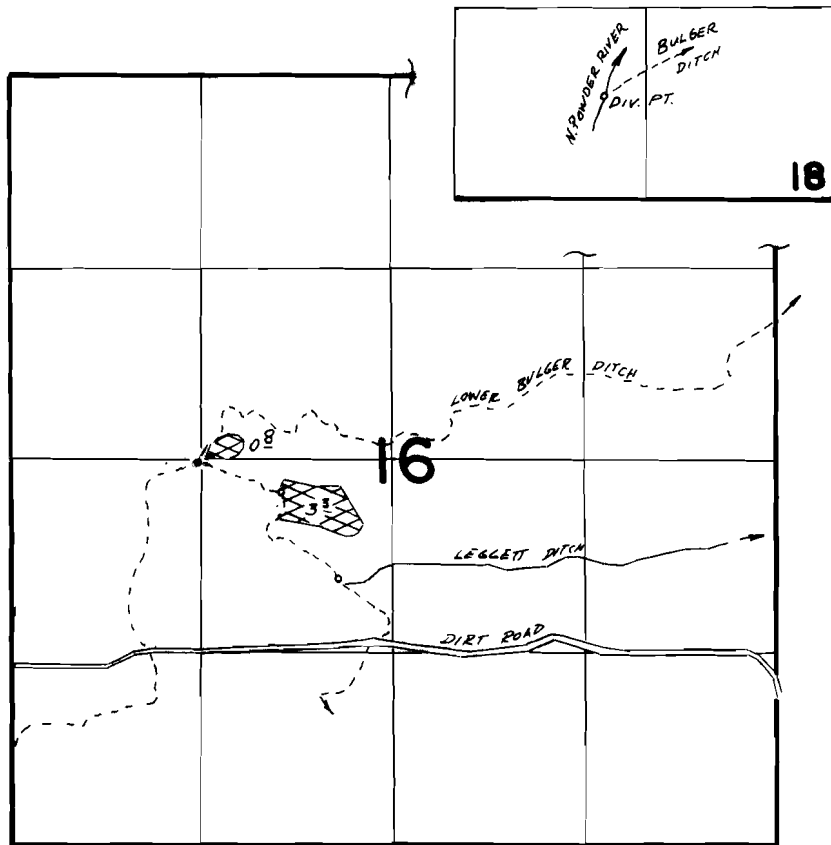

DIV. PT. LOC. 700' N. & 1620' W FROM SE COR. SEC. 18

FINAL PROOF SURVEY
UNDER

Application No. **57045** Permit No. **43049**
IN NAME OF

BILL LOENNIG

Surveyed *April 15* 1982, by *J.R. Church*