


T. 9S. R. 45E. W.M.

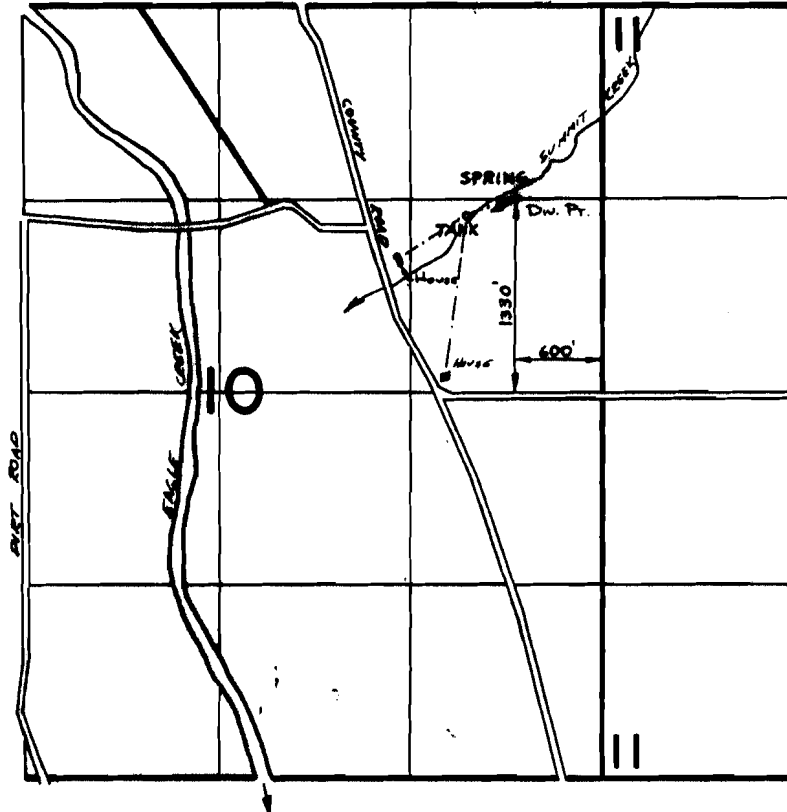

**FINAL PROOF SURVEY**  
UNDER

Application No. **57093** Permit No. **42942**  
IN NAME OF

.....**GILL C. WRIGHT**.....

Surveyed ...**11-15**... **1972**., by **R. BARWIN**.....