


T. 35 S., R. 3 W., W.M.

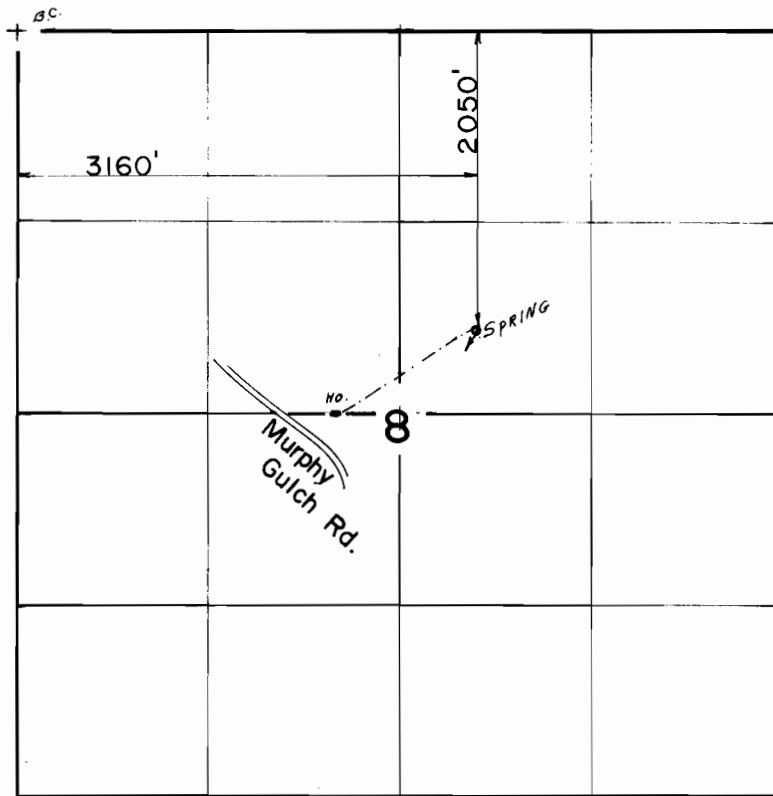

Scale: 1" = 1320'

**FINAL PROOF SURVEY**  
UNDER

Application No. 57151... Permit No. 42955...  
IN NAME OF

...RICHARD J. DUMANOWSKI...

Surveyed JUN. 15. 1987, by B. S. JAMES...