


T. 7 S., R. 6 W., W. M.

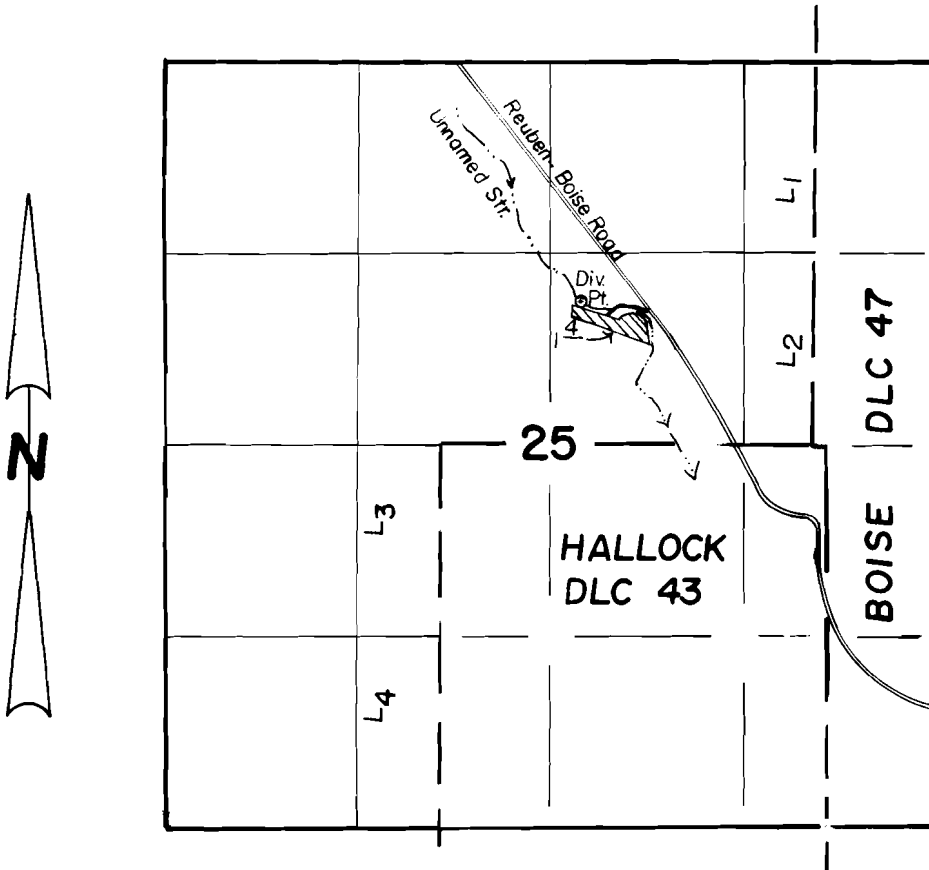

Div. Pt. Loc.: 1650' S. & 2450' W. from the NE Cor. of Sec. 25.

Scale: 1" = 1320'

FINAL PROOF SURVEY
UNDER

Application No. **57255**. Permit No. **43000**.....
IN NAME OF

INGVAR B. LAMBERT.....

Surveyed **SEPT. 11, 1983**, by **L. TOLL**.....