


90884

T. 40 S., R. 9 W., W. M.

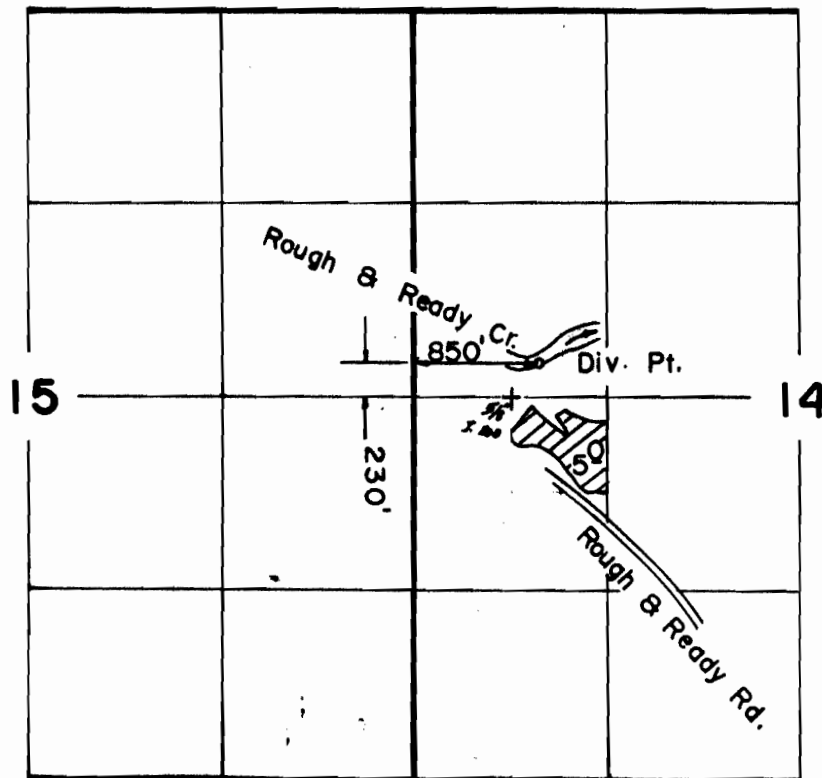

Scale: 1" = 1320'

FINAL PROOF SURVEY
UNDER

Application No. **57264** Permit No. **43112**
IN NAME OF

JIM WOOD

Surveyed APR. 10. 1986, by R. S. JAMES.