


T. 33 S., R. 7 W., W. M.

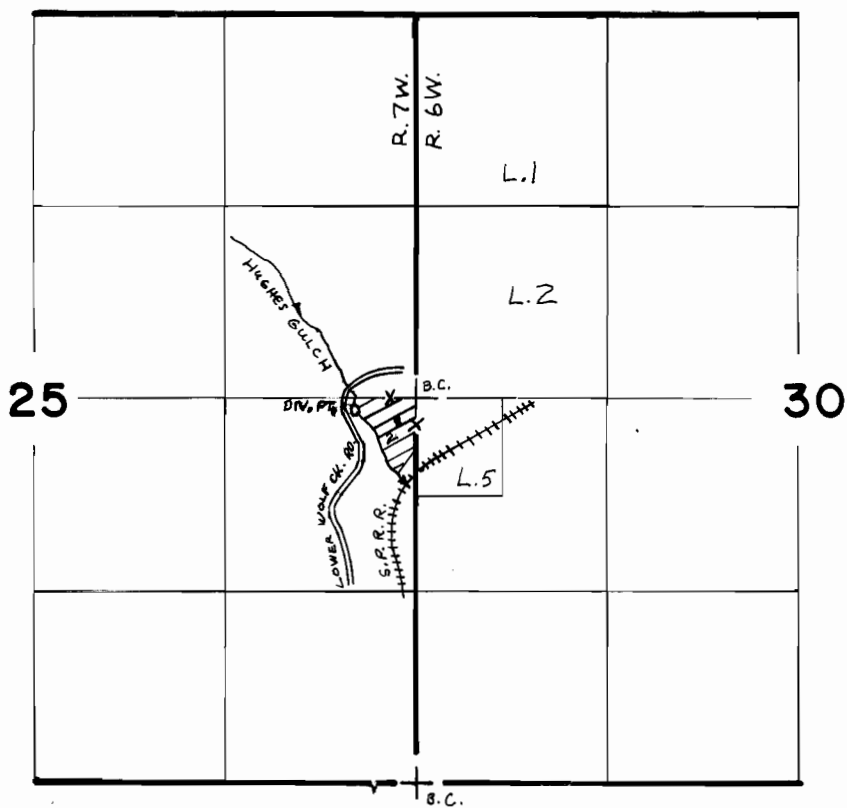

DIV. PT.: 90' S. & 420' W. FROM E. 1/4 COR. SEC. 25

SCALE: 1"=1320'

FINAL PROOF SURVEY UNDER

Application No. 57276... Permit No. 43114.....
IN NAME OF

VERA JEAN & CORINNE E. STUMBO

Surveyed SEPT. 6 1984, by J. WOODROOF