


T. 35 S., R. 4 W., W.M.

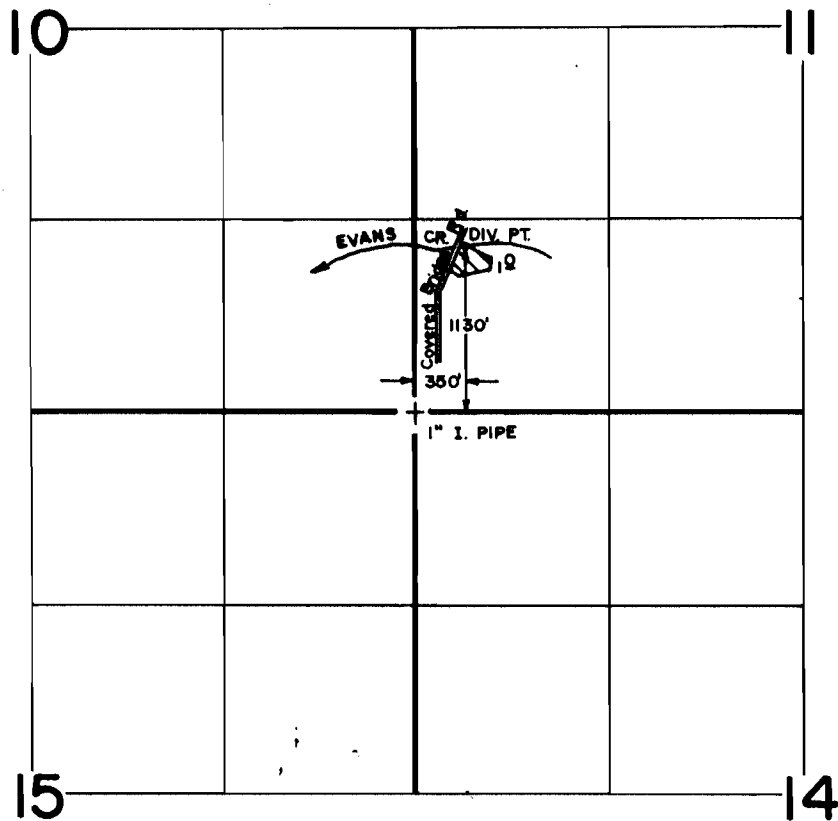

FINAL PROOF SURVEY
UNDER

Application No. 57345 Permit No. 43157.....
IN NAME OF

MAY A. ELLIS.....

Surveyed DEC. 13, 1983, by B. S. JAMES.....

SCALE: 4" = 1 MILE