


T.36S. R.14W. W.M.

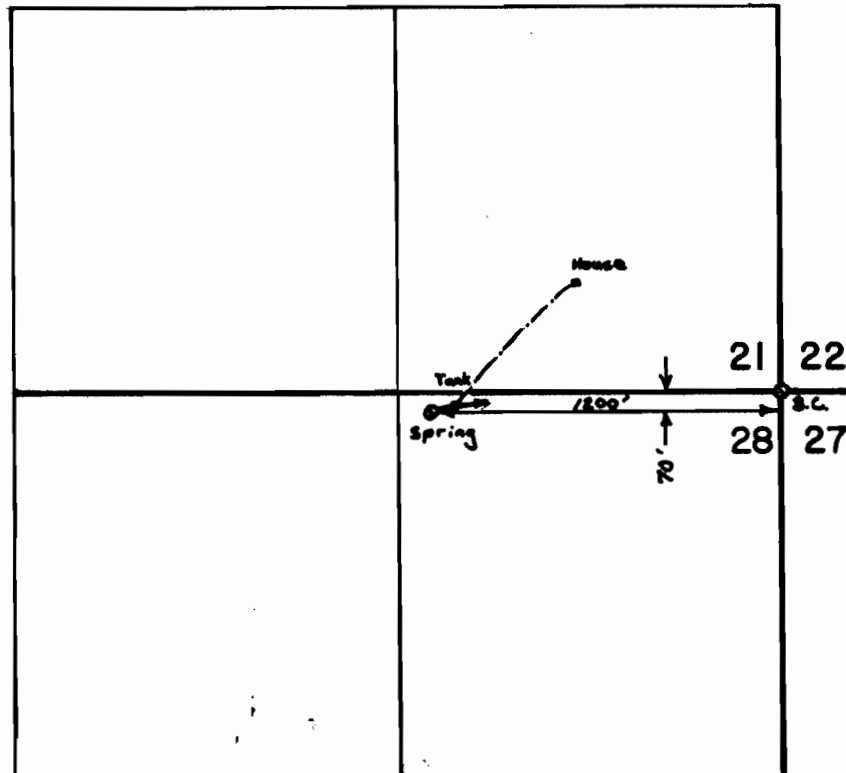

SCALE : 8" = 1 mile

FINAL PROOF SURVEY
UNDER

Application No. 57326 Permit No. 43186
IN NAME OF

ERNEST HATCH

Surveyed June 5, 1978, by D. Sparks