


T. 1 & 2 N., R. 3 W., W.M.

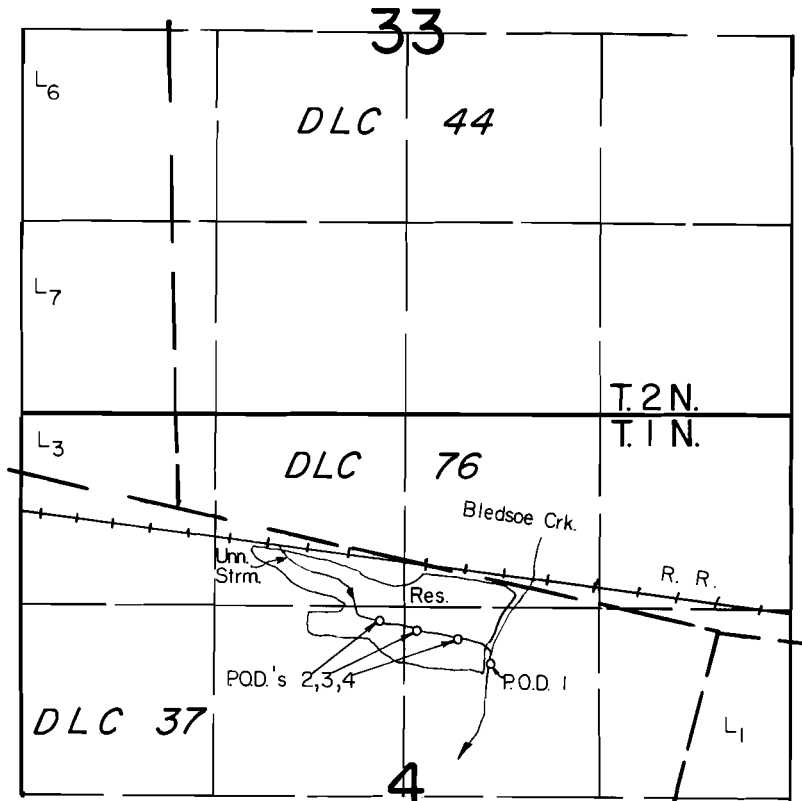

P.O.D. 1 (Bledsoe Crk.) Loc. : 1050' S. & 2140' E.
 P.O.D. 2 Loc. : 770' S. & 1360' E.
 P.O.D. 3 Loc. : 850' S. & 1610' E.
 P.O.D. 4 Loc. : 900' S. & 1900' E.
 All from SW Cor. DLC 76.

Scale : 1" = 1320'

FINAL PROOF SURVEY
 UNDER

R-58141 R-8482

Application No. 58142 Permit No. 46940.....

IN NAME OF

SIDNEY T. & PAULINE A. GOBEL

Surveyed March 29 1988, by T. Warren.....