


T.1&2N., R.3W., W.M.

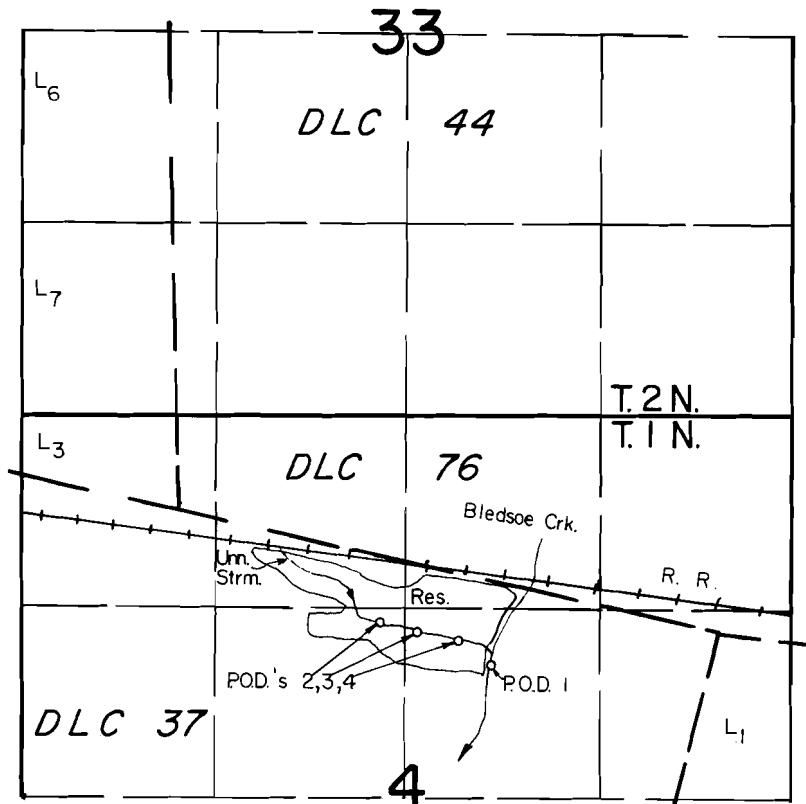

P.O.D. 1 (Bledsoe Crk.) Loc. : 1050' S. & 2140' E.  
 P.O.D. 2 Loc. : 770' S. & 1360' E.  
 P.O.D. 3 Loc. : 850' S. & 1610' E.  
 P.O.D. 4 Loc. : 900' S. & 1900' E.  
 All from SW Cor. DLC 76.

Scale : 1" = 1320'

**FINAL PROOF SURVEY**

UNDER

R-58141

R-8482

Application No. 58142 Permit No. 46940

IN NAME OF

**SIDNEY T. & PAULINE A. GOBEL**

Surveyed March 29 1988, by T. Warren