



T. 4S., R. 39E., W.M.

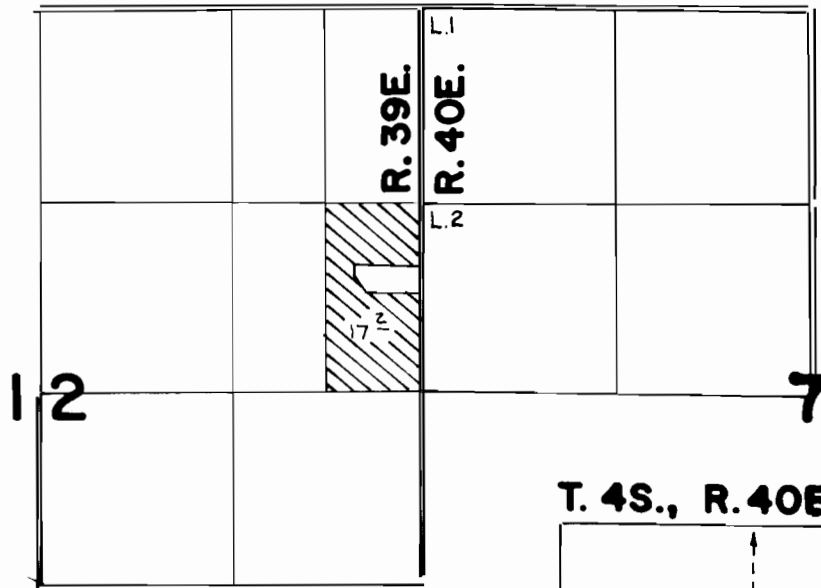

T. 4S., R. 40E., W.M.

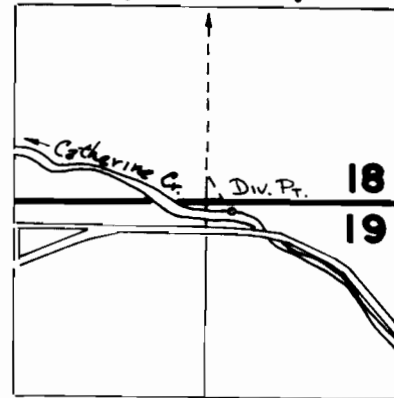

SCALE 1" = 1320'

Div. Pt. Loc: 60'S. & 1150'W FROM NE COR. SEC. 19

FINAL PROOF SURVEY
UNDER

Application No. **58266** Permit No. **44007**
IN NAME OF

SHERMAN E. HAWKINS

Surveyed 4-14-1987 by V.L. Church