


P-45585
C-60497

T. 13 S., R. 26 E., W.M.

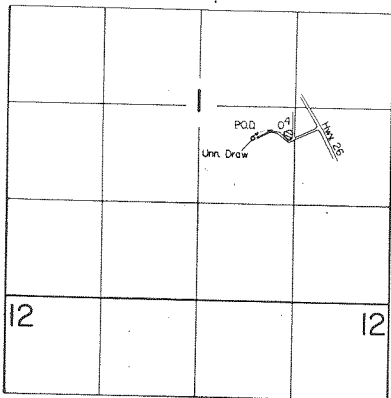

P.O.D. Loc.: 440' S. & 560' W. from NE Cor. NW 1/4 SE 1/4, Sec. 5.

Scale: 1" = 1320'

FINAL PROOF SURVEY
UNDER

Application No. 58995 Permit No. 45585
IN NAME OF

JOHN W. MASCALL &/or CONNIE MOORE

Surveyed JUNE 20 1988, by T. Warren

AW

41023-179-72L
12/2/88 TMM