


T. 11 S., R. 2 W., W.M.

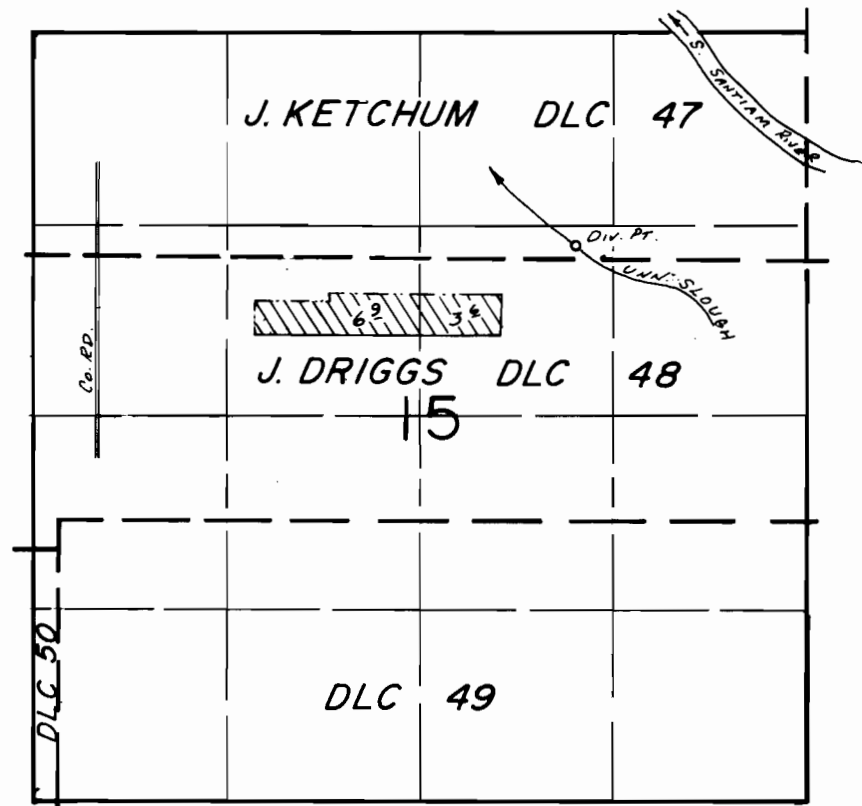

DIV. PT. LOC.: 90' N. & 1570' W FROM SE COR. J. KETCHUM DLC 47.

SCALE: 1" = 1320'

# FINAL PROOF SURVEY

UNDER

Application No. 59411... Permit No. 44734...  
IN NAME OF

BOYD H. & MARILYN A. BEWLEY

Surveyed June 12, 1986, by B.W. BISHOP

11/18/86  
RWB