


T. 12 &amp; 13 S., R. 26 E., W.M.

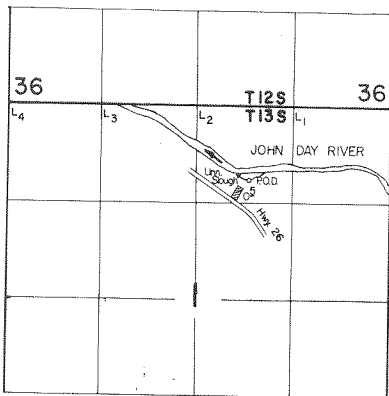

P.O.D. Loc. : 1010' S. &amp; 740' E. from N. 1/4 Cor., Sec. 1

Scale : 1" = 1320'

### FINAL PROOF SURVEY

UNDER

Application No. 59414 Permit No. 44526

IN NAME OF

LINDA MacARTHURSurveyed JUNE 20 1988, by T. Warren