
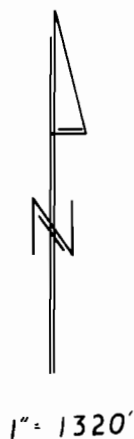


T48&5N R7W WM

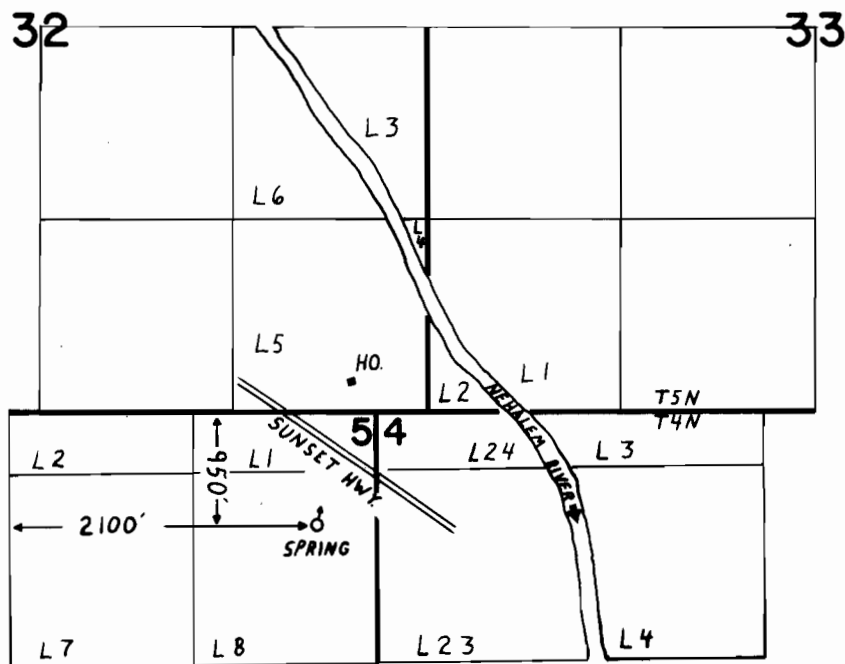

FINAL PROOF SURVEY UNDER

Application No. 59470.. Permit No. 44555.....
IN NAME OF

NORMAN C. PAULEY

Surveyed AUG 16 1988, by T.M. WARREN.