


T. 2S., R. 44E., W. M.

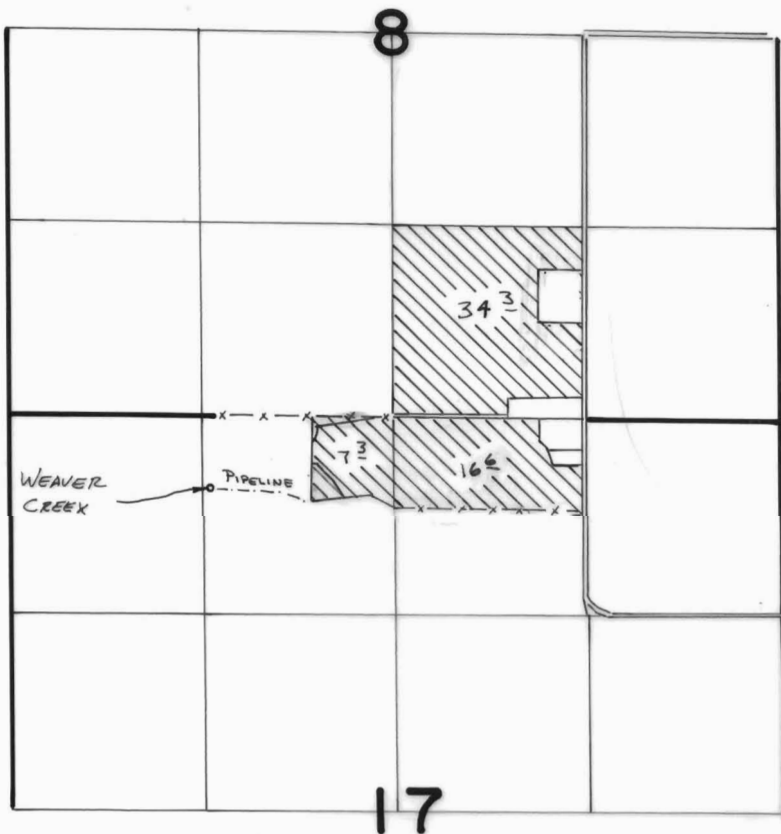

SCALE 1" = 1320'

Div Pt. Loc: 500'S & 1270'W. FROM N¹/₄ COR SEC.17

FINAL PROOF SURVEY
UNDER

Application No. **60034** Permit No. **45050**..
IN NAME OF

.....**OSCAR L. WINGARD**.....

Surveyed **8-1-1988**, by **V.L. Church**.....