


T. 26S., R. 13W., W.M.

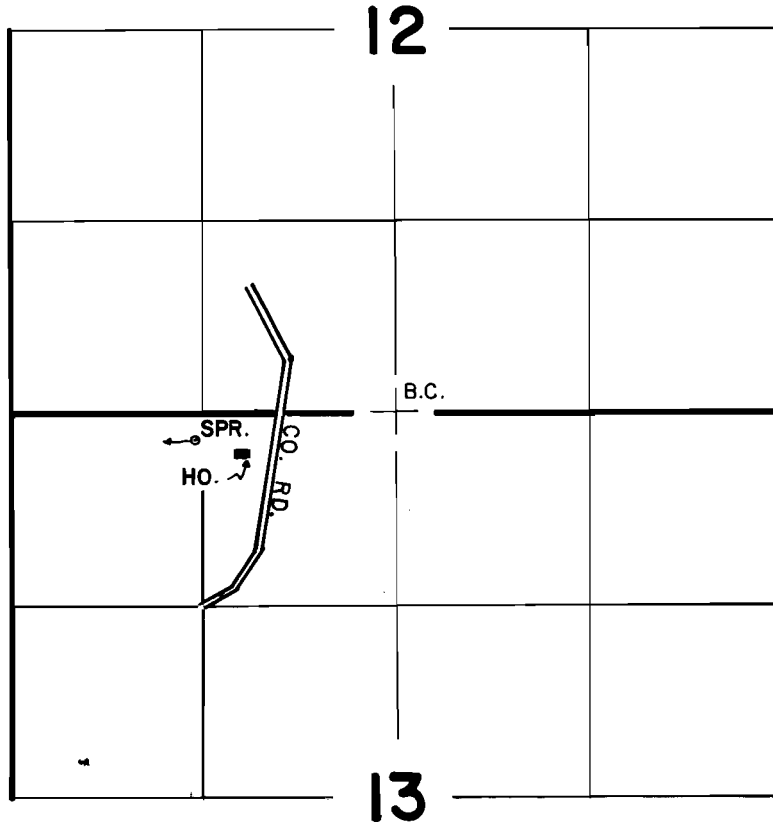

SPRING LOCATED 180' S. & 1350' W. OF N. 1/4 COR. SEC. 13.

SCALE: 4" = 1 MILE

FINAL PROOF SURVEY
UNDER

Application No. 60597... Permit No. 46365.....
IN NAME OF

EDWARD W. & VIOLET J. NAPIER

Surveyed JULY 29 1986, by J. M. SCHMORDE