


T. 26S., R. 13W., W.M.

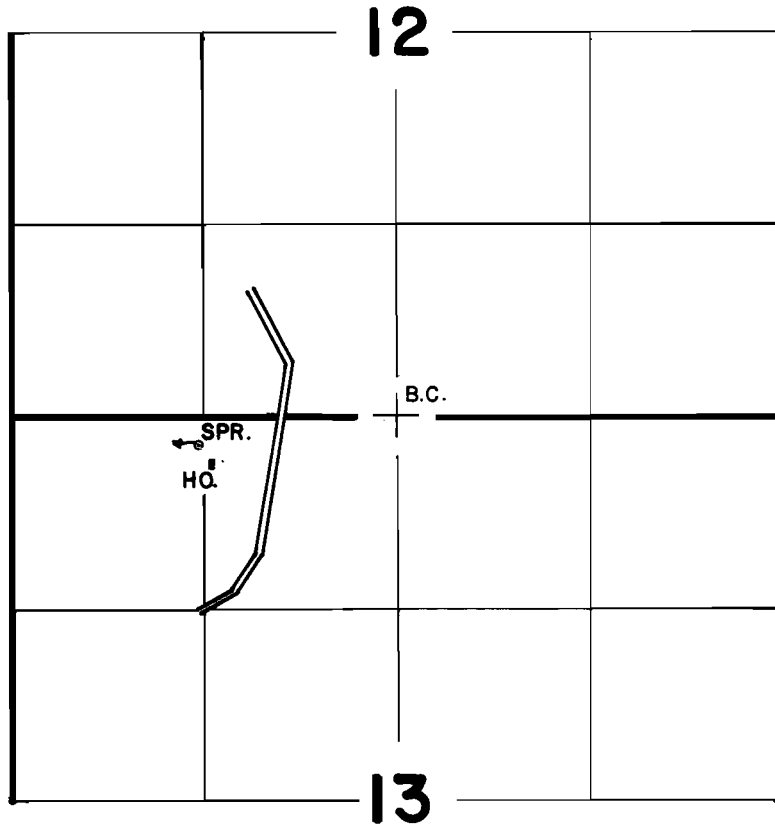

SPRING LOCATED 180' S. & 1350' W. OF N. 1/4 COR. SEC. 13.

SCALE: 4" = 1 MILE

FINAL PROOF SURVEY UNDER

Application No. 60601 Permit No. 46366
IN NAME OF

STANLEY N. & VIRGINIA D. FUSS

Surveyed JULY 29 1986, by J. M. SCHMORDE