


T. 11 S., R. 6 W., W. M.

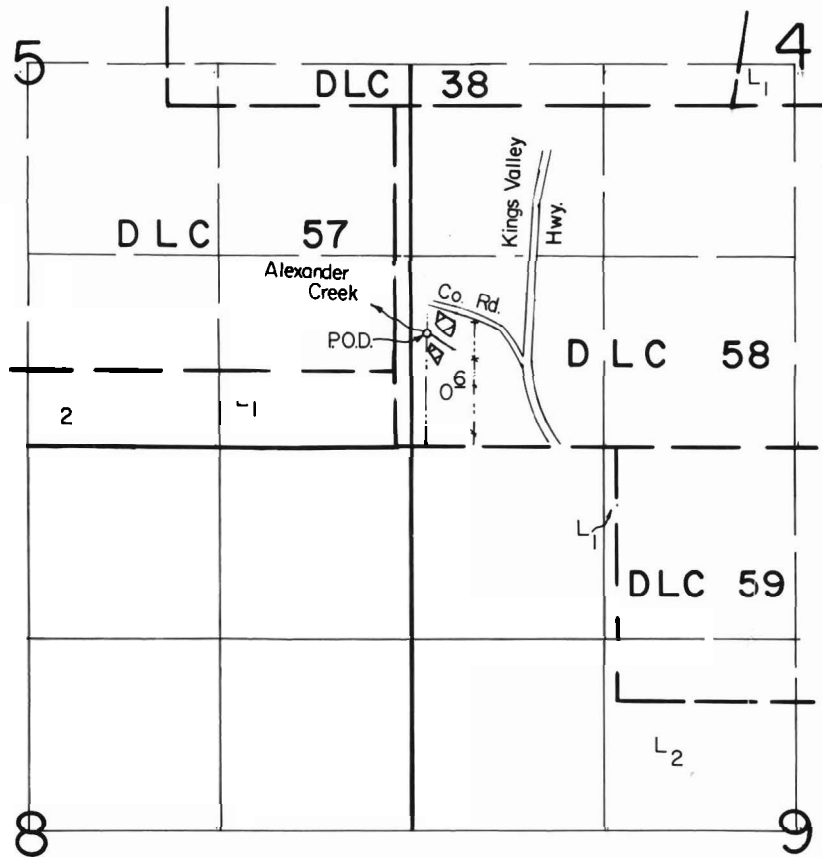

P.O.D. Loc.: 800' N. & 100' E. from SW Cor. Sec. 4.

Scale: 1" = 1320'

FINAL PROOF SURVEY UNDER

Application No. **60608** Permit No. **45351**
IN NAME OF

MARTIN & MARLENE McDONALD

Surveyed **JULY 31 1984**, by **L. TOLL**
MAY 5 1987, by **T. WARREN**

PTS-1984-Z
11/1/88 TMW