


T.2N., R.2W., W.M.

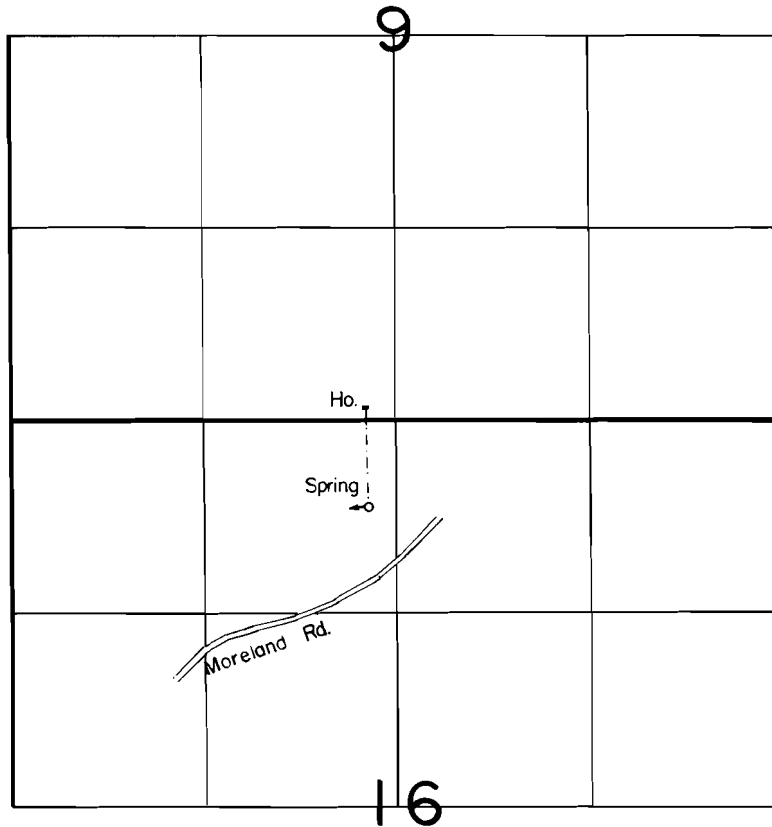

Spring Loc.: 600' S. & 180' W. from N. 1/4 Cor. Sec. 16.

Scale: 1" = 1320'

FINAL PROOF SURVEY
UNDER

Application No. 60713 Permit No. 46580

IN NAME OF

LEONARD W. EVANS

Surveyed March 29 1988, by T. Warren