


T.41 S., R.21 E., W.M.

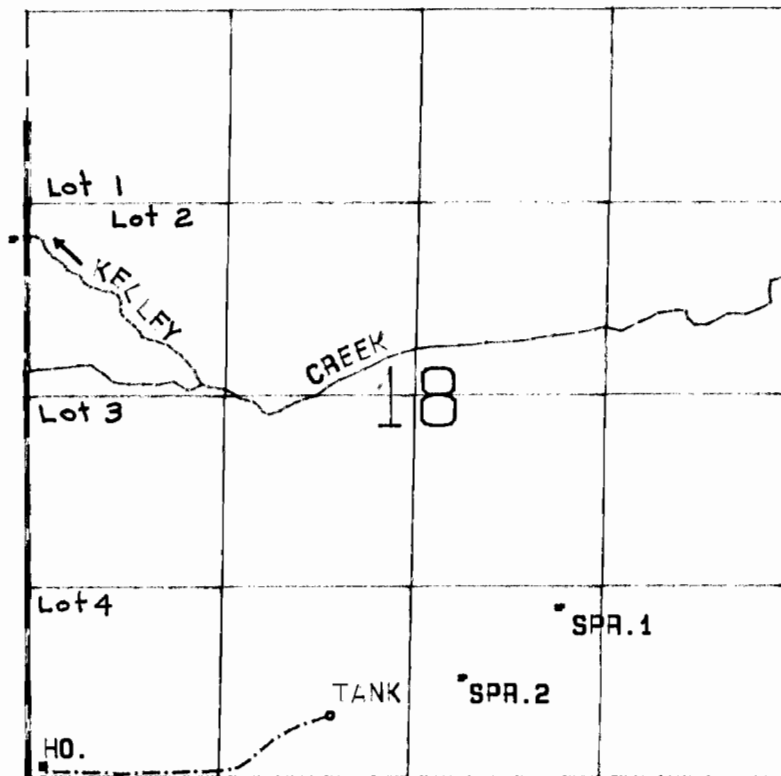

SCALE: 1" = 1320'

SPRING 1 LOCATED 1170 FT. N. AND 3660 FT. E. FROM SW. COR. SEC. 18

SPRING 2 LOCATED 680 FT. N. AND 2990 FT. E. FROM SW. COR. SEC. 18

FINAL PROOF SURVEY
UNDER

Application No. 68011 Permit No. 48311

IN NAME OF

RAYMOND FISHER

Surveyed Oct. 16, 1987 By V.L. CHURCH

Photo: 379-1708C JCL-GIS