


T. 1N., 1S., R. 4&5W., W. M.

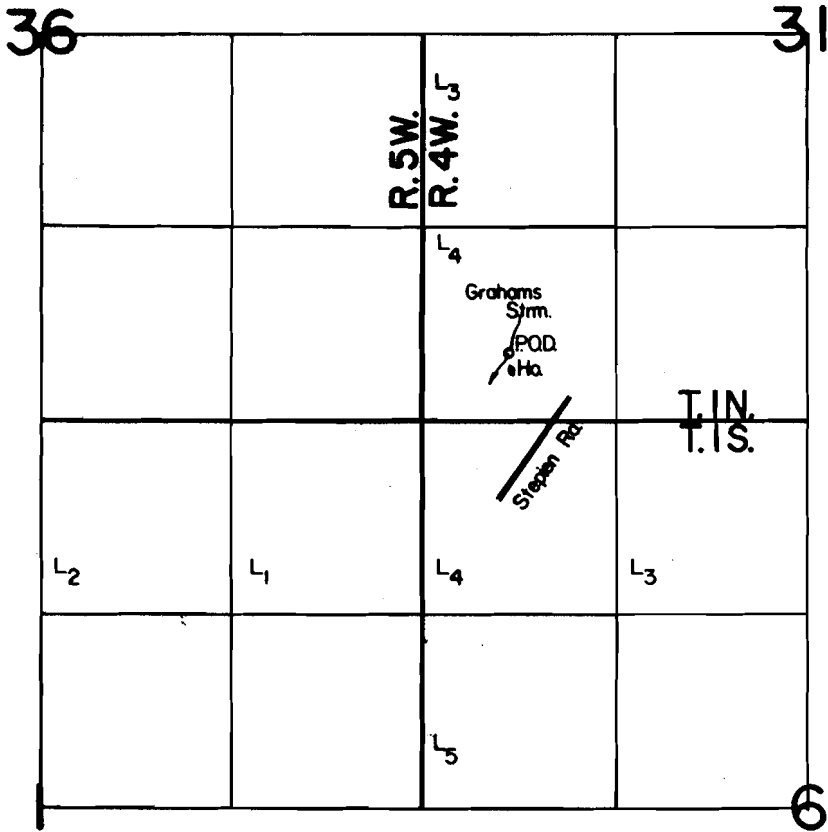

P.O.D. Loc. : 460' N. & 600' E. from SW Cor. Sec. 31.

Scale : 1" = 1320'

FINAL PROOF SURVEY
UNDER

Application No. 61100..... Permit No. 45513.....
IN NAME OF

HUBERT G. & PATRICIA N. GRAHAM

Surveyed JULY 29, 1988, by T. Warren.....