


T5N, R7W, WM

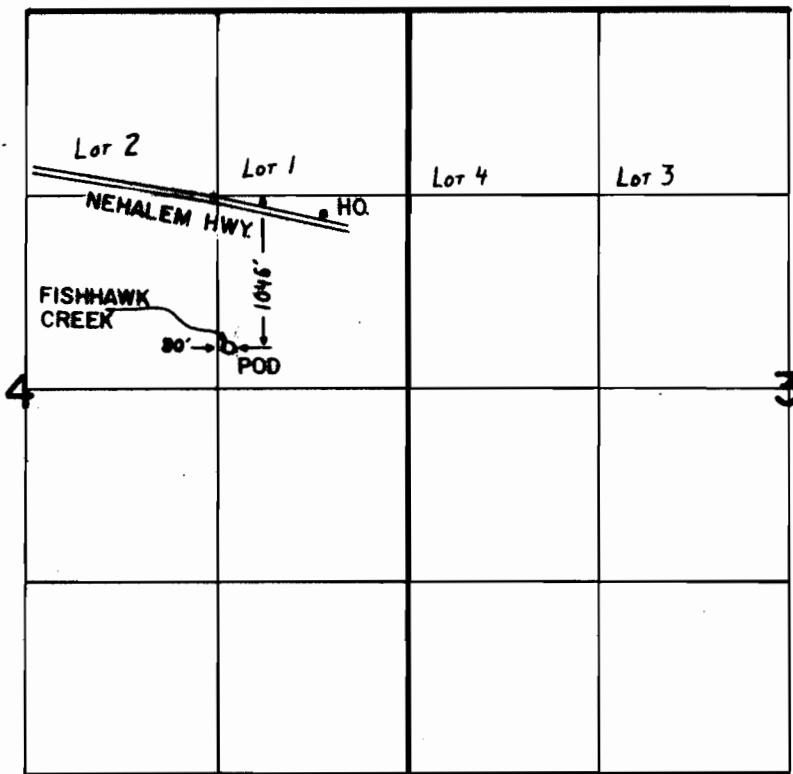

N



1"=1320

FINAL PROOF SURVEY UNDER

Application No. 61341.... Permit No. 45631.....
IN NAME OF

.....GARRY WILLIAM HOLMES.....

Surveyed AUG. 16... 1988., by J.M. WARREN.....