


P-45797
C-60515

T. 12 S., R. 26 E., W.M.

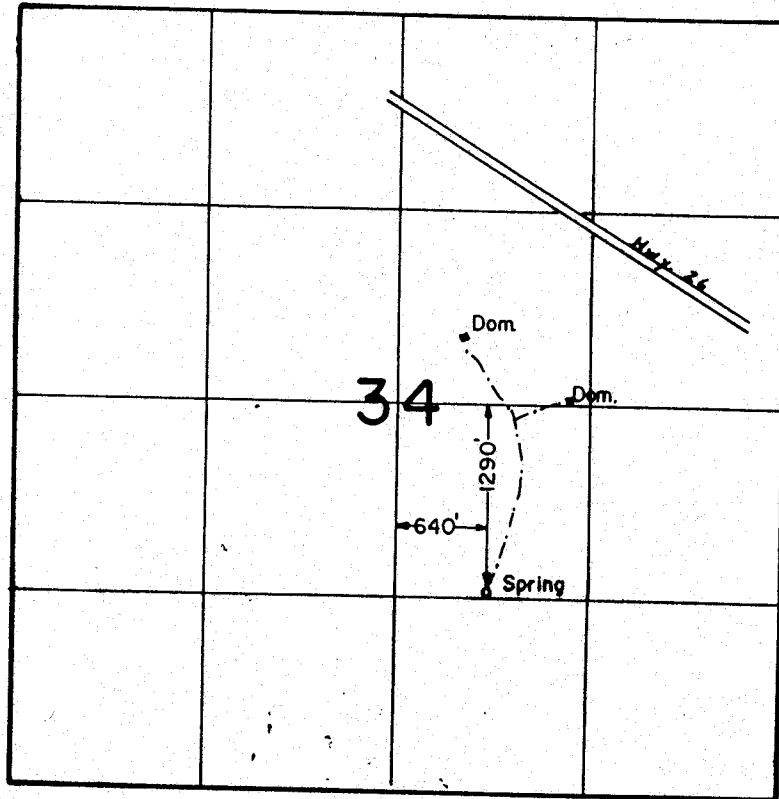

Scale: 1" = 1320'

FINAL PROOF SURVEY
UNDER

Application No. 61684 Permit No. 45797
IN NAME OF

GARY MOULTON

Surveyed JUNE 18 1988, by T. Warren