


T3S, RIOW, WM

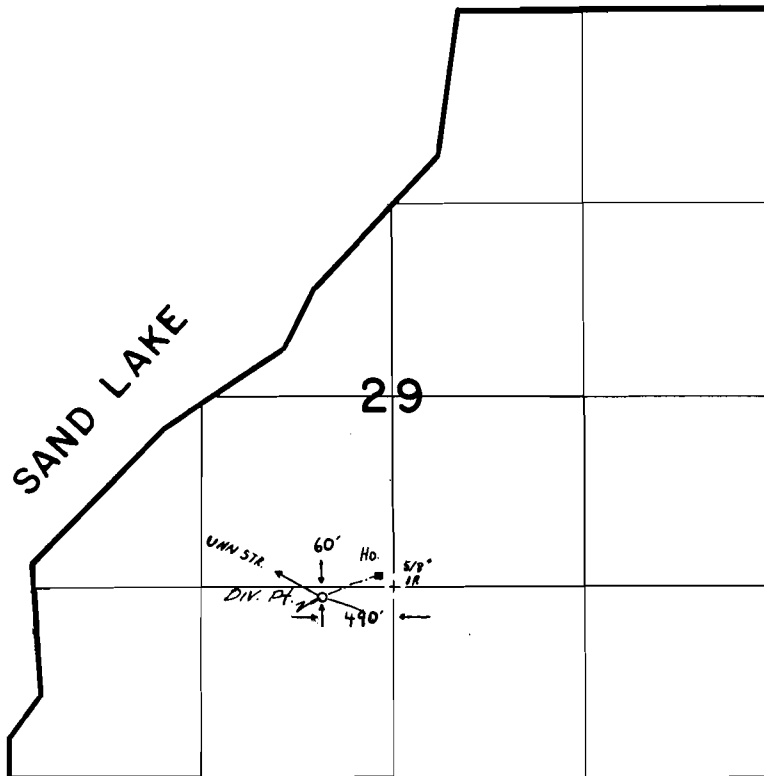

FINAL PROOF SURVEY UNDER

Application No. 61769 Permit No. 45977

IN NAME OF

DANIEL L. & CAROL J. GRIFFITH

Surveyed SEPT. 28, 1987, by B.W. BISHOP