


T. 7 S., R. 38 E., W.M.



The location of the div. pt. is 300' S. & 1970' W. from the NE cor. sec. 22.

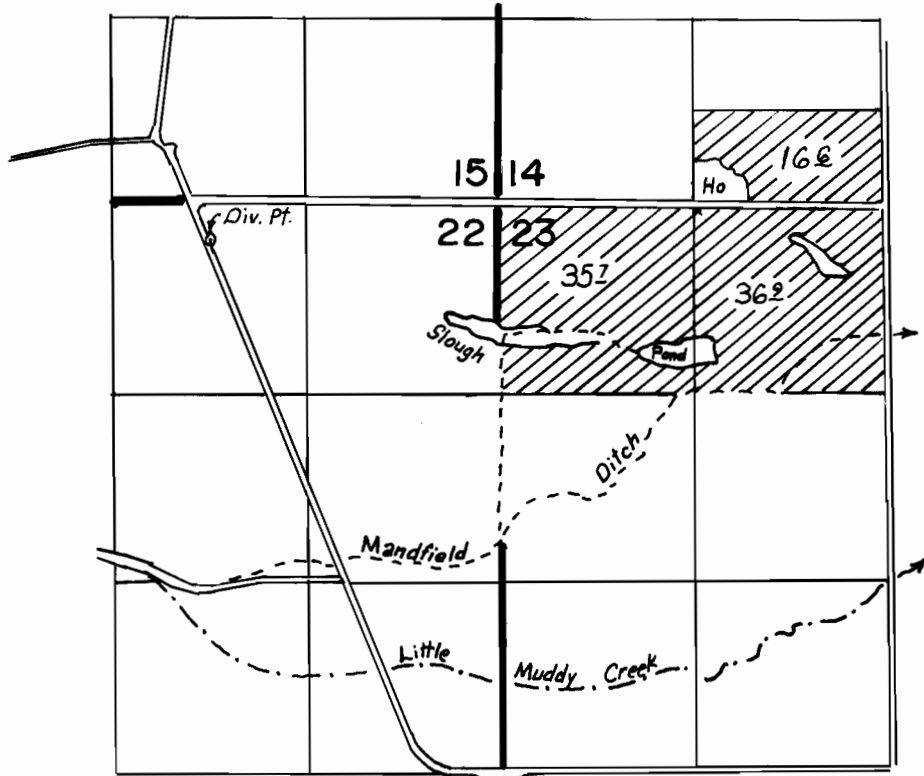

Scale : 1" = 1320'

FINAL PROOF SURVEY UNDER

Application No. **62178** Permit No. **46385**
IN NAME OF

JOSEPHINE J. JENSEN

Surveyed **6-3** 19**88**, by **Vern Church**