
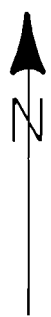


T. 22 S., R. 7 W., W. M.

SECTION 20

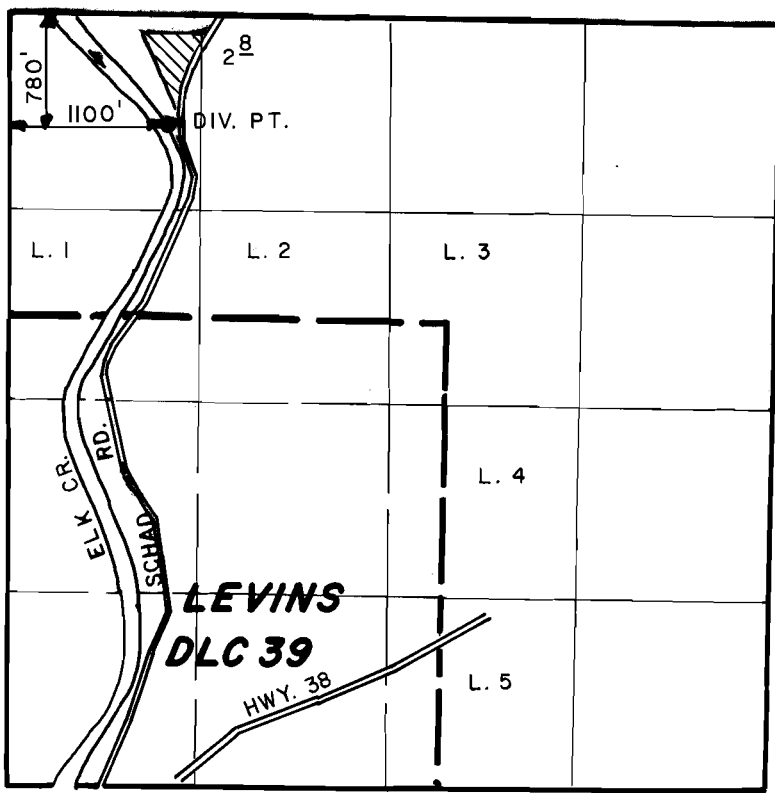

SCALE: 4" = 1 MILE

FINAL PROOF SURVEY UNDER

Application No. 62357 Permit No. 46514
IN NAME OF

DIANE CASSIDY

Surveyed AUG. 25, 1987, by J. M. SCHMORDE