


RECEIVED

SEP 9 1981
WATER RESOURCES DEPT.
SALEM, OREGON

T. 9S. R. 1E., W.M.

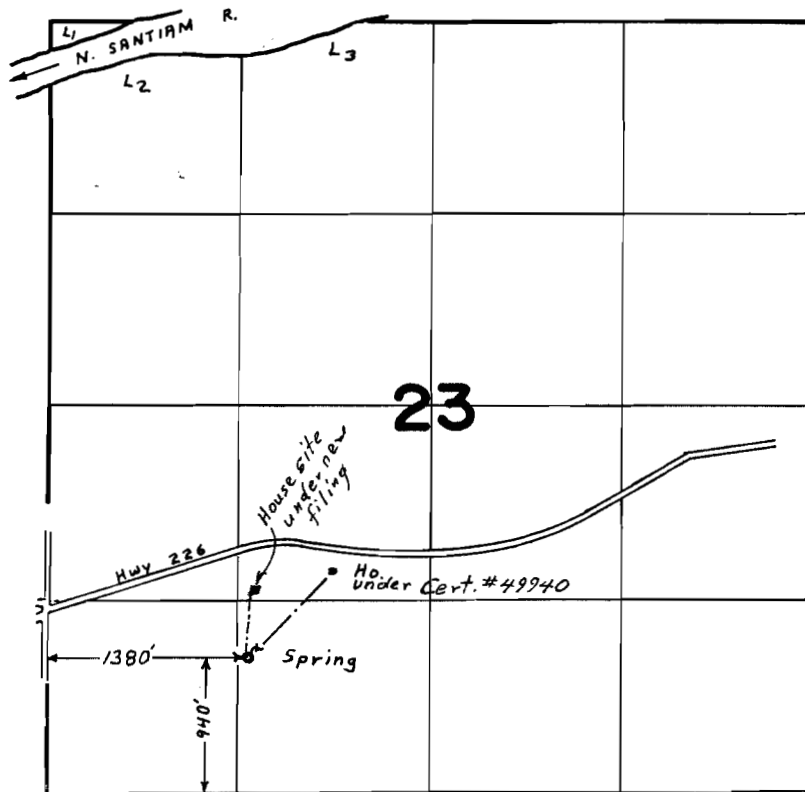

Application No. 62603
Permit No. 46392