


APPLICATION
Application No. #63275
Permit No. 47300

Pg. 1 of 6

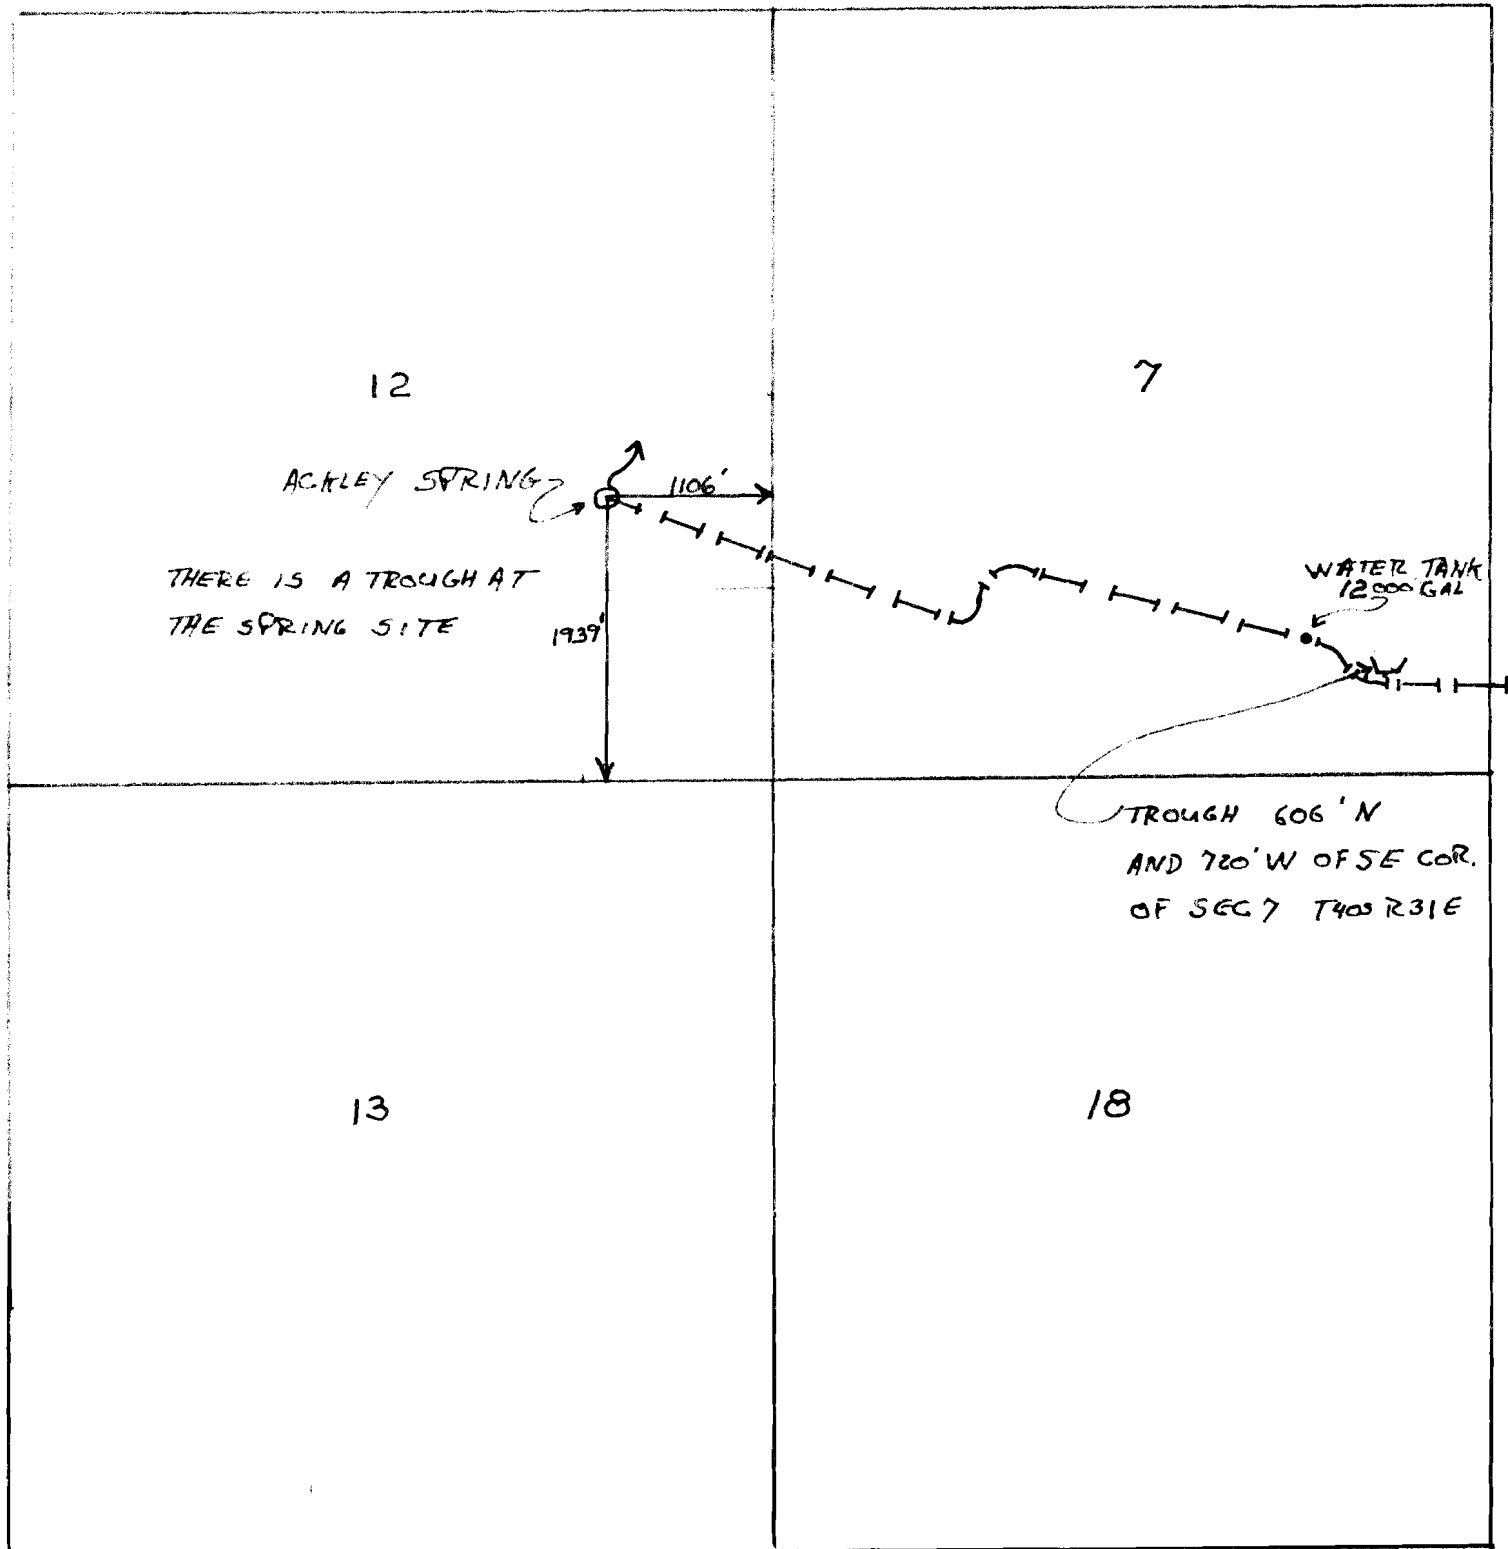

T40S R30E WBM

T 40S R31E WBM

RECEIVED

NOV 15 1982


WATER RESOURCES DEPT.

RECEIVED

JAN 17 1983

WATER RESOURCES DEPT.
SALEM, OREGON

N

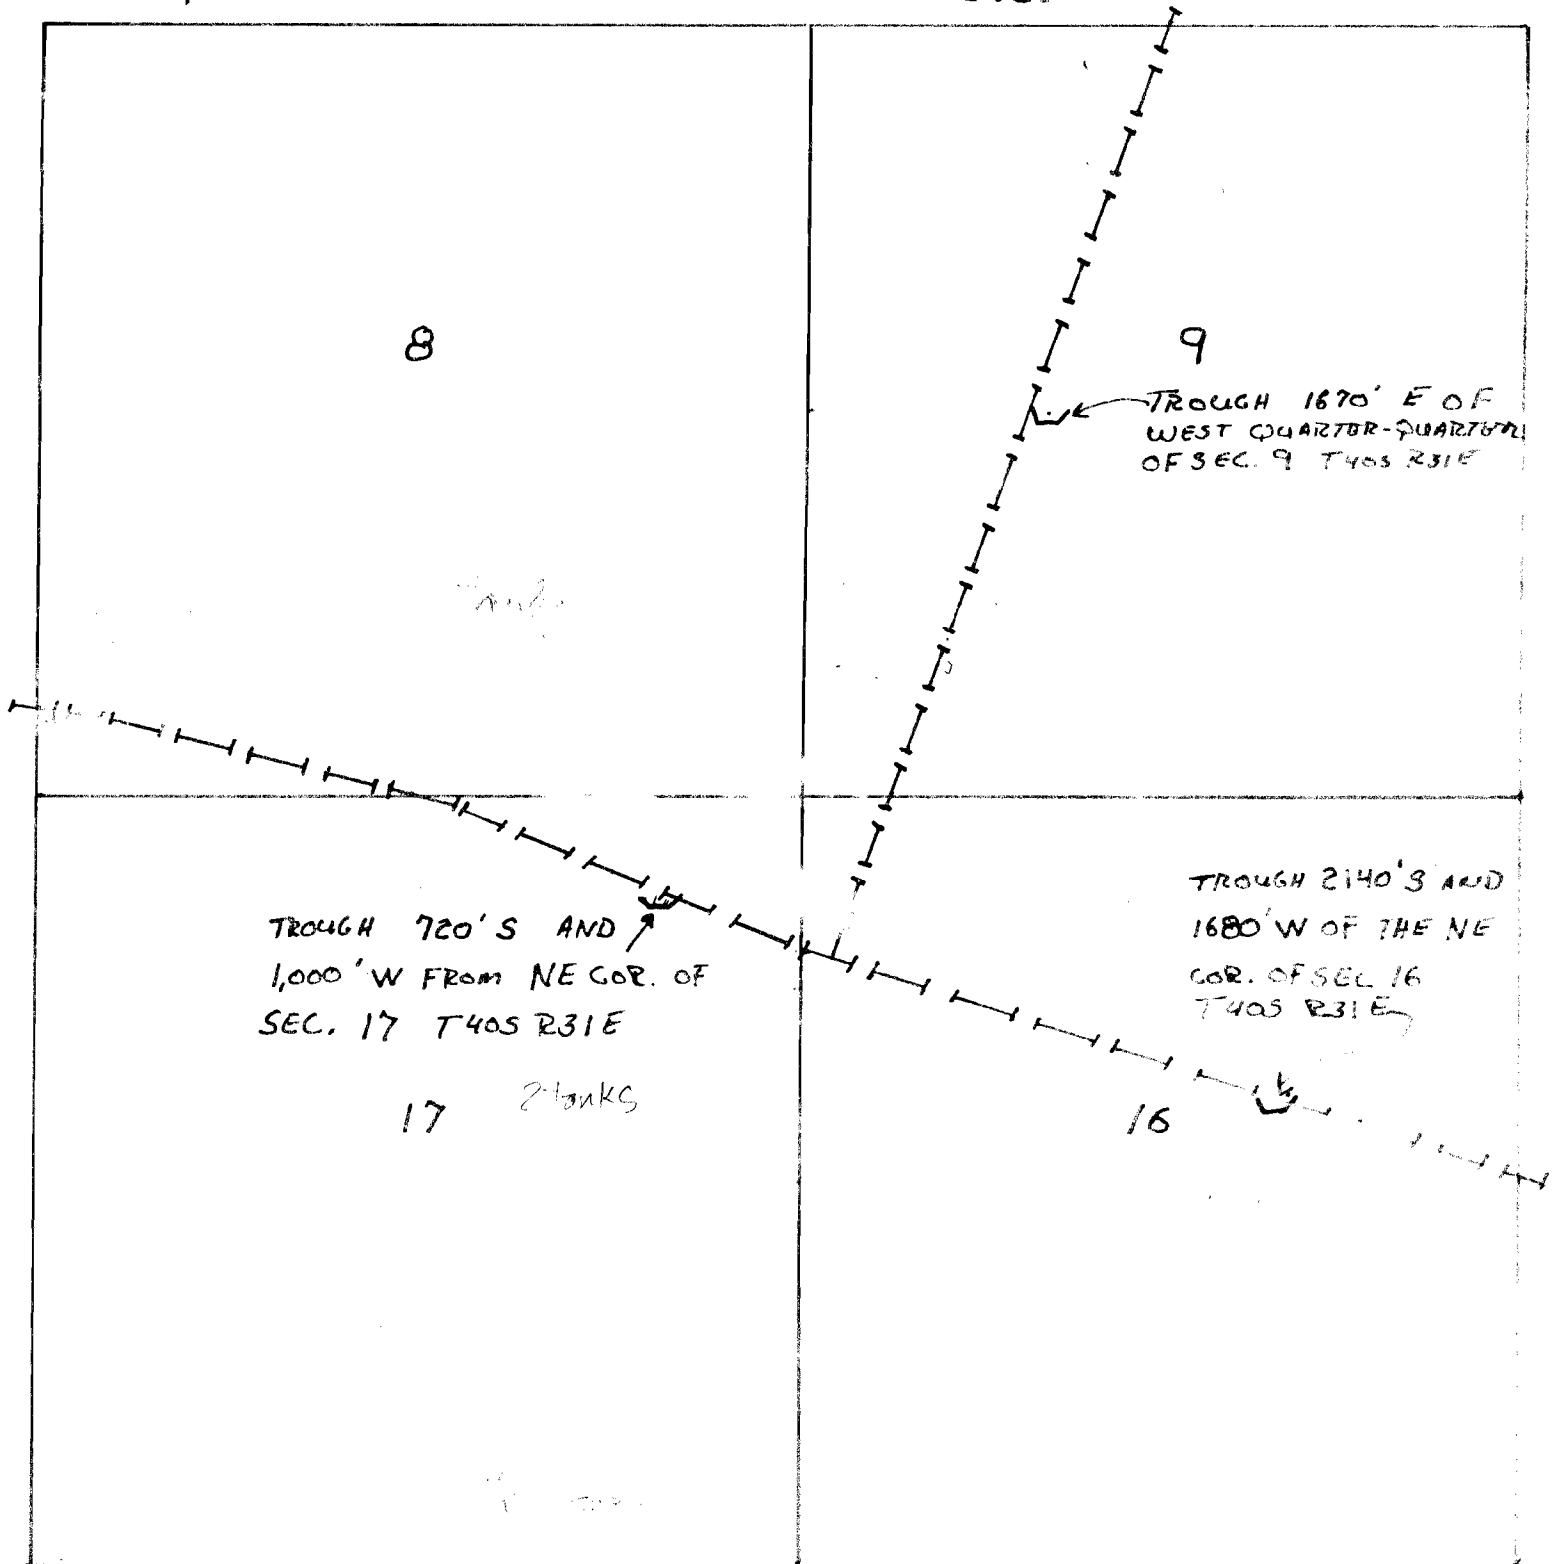


RECEIVED

JAN 17 1983
WATER RESOURCES DEPT.
SALEM, OREGON

T40S R31E WBM

RECEIVED

NOV 15 1982
WATER RESOURCES DEPT.
SALEM, OREGON

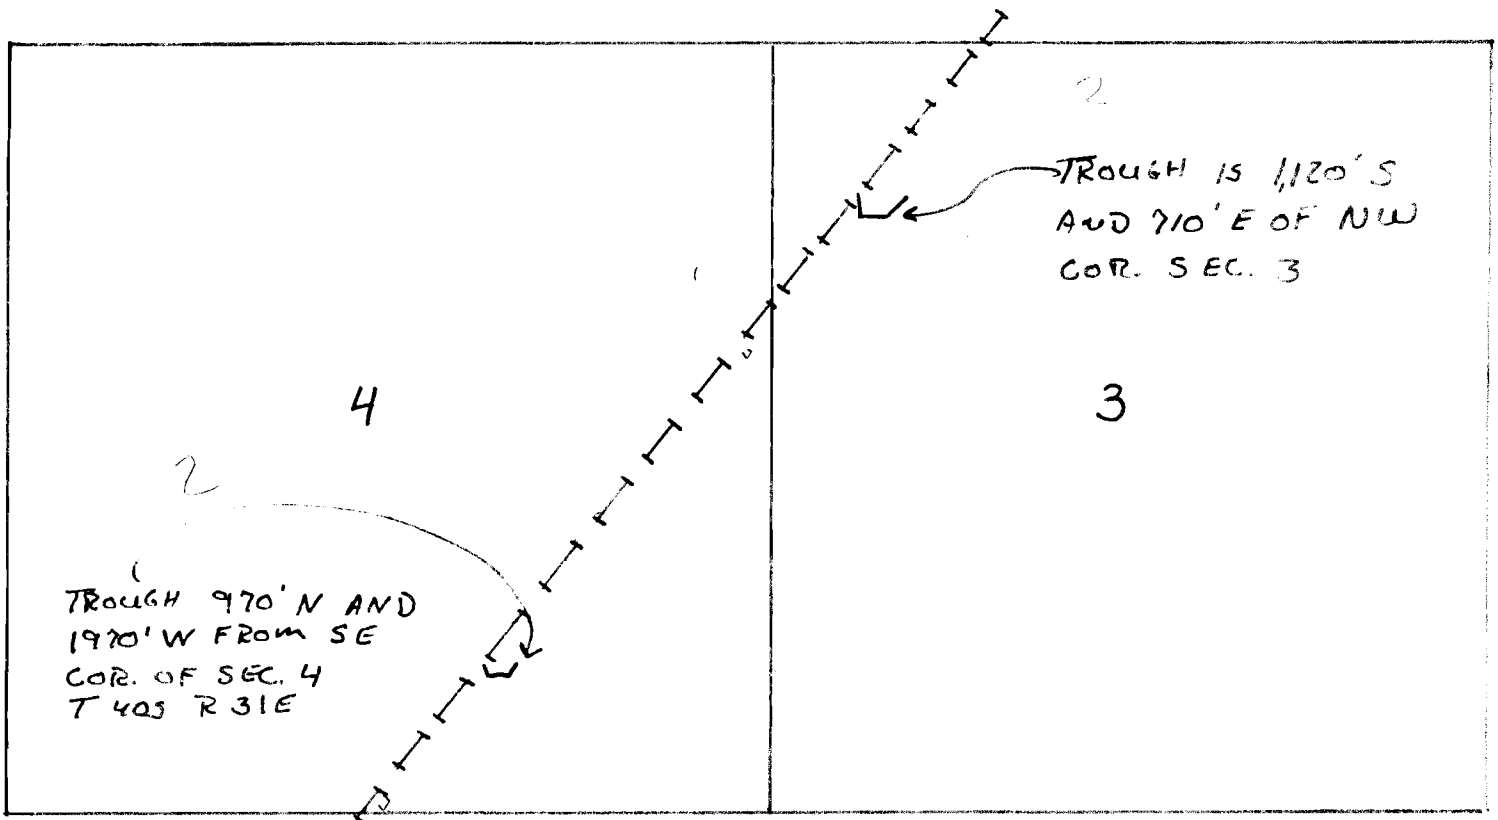


T 40S R 31E W 8M

RECEIVED
JAN 17 1983
WATER RESOURCES DEPT.
SALEM, OREGON

RECEIVED
NOV 15 1982
WATER RESOURCES DEPT.
SALEM, OREGON



Application No. APPLICATION #63275
Permit No. 47300 Pg. 6 OF 6

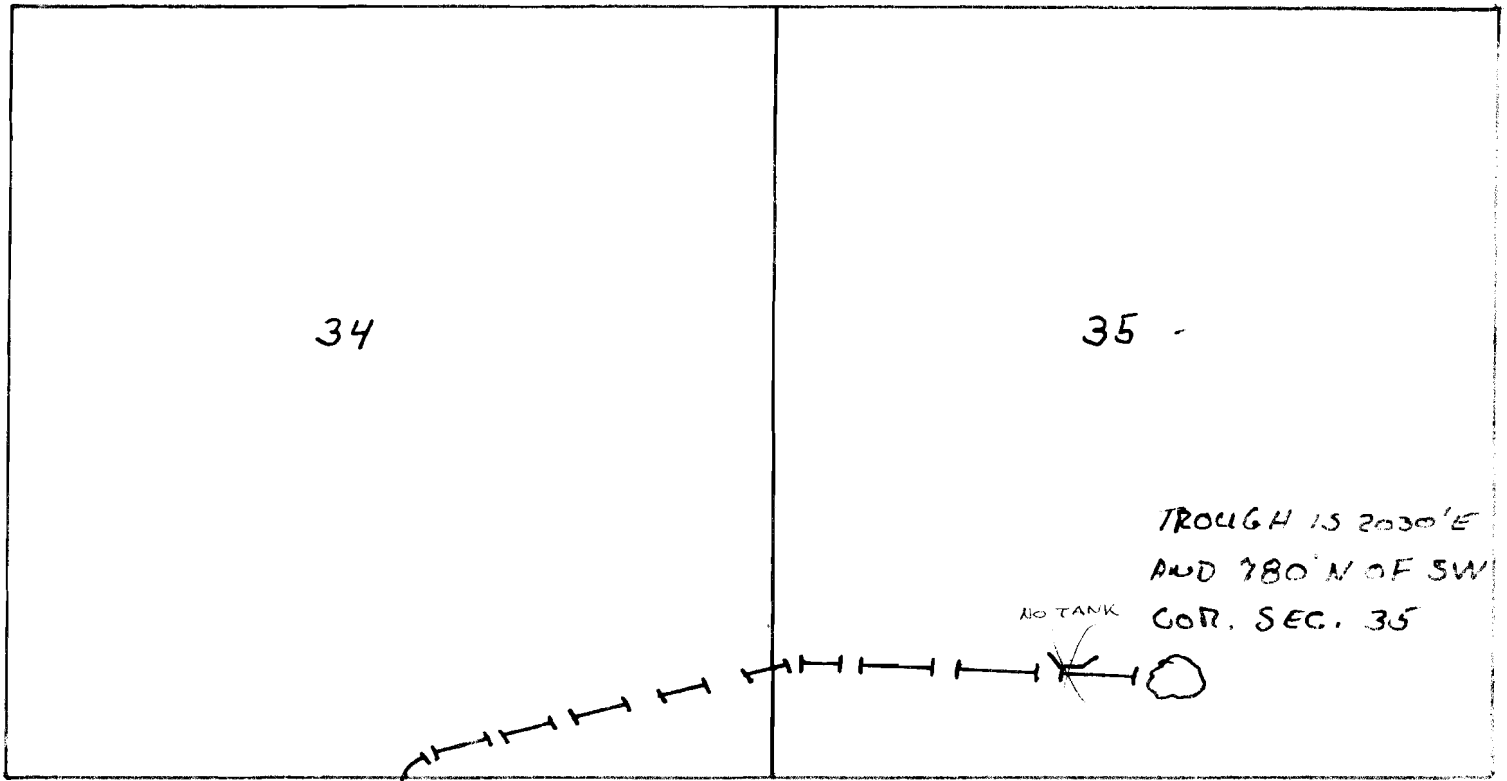

T39S R31E W8M

RECEIVED

JAN 17 1983

WATER RESOURCES DEPT.
SALEM, OREGON

RECEIVED


NOV 15 1982

WATER RESOURCES DEPT.
SALEM, OREGON

4
N

APPLICATION
Application No. # 63275
Permit No. 47300

Pg. 3 of 6

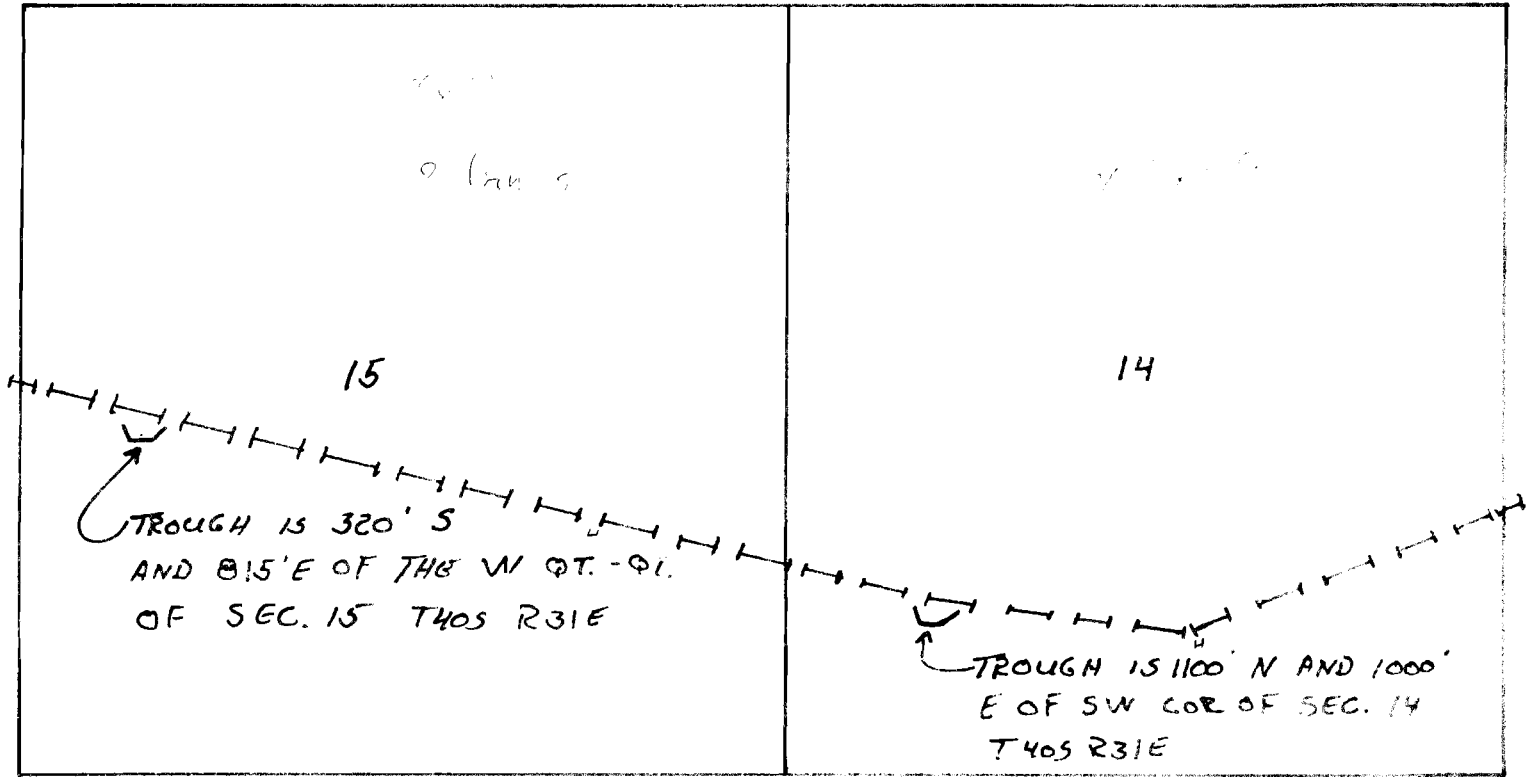

T40S R31E W.B.M.

RECEIVED

JAN 17 1983


WATER RESOURCES DEPT. SALEM, OREGON

RECEIVED

NOV 15 1982

WATER RESOURCES DEPT. SALEM, OREGON

4
N

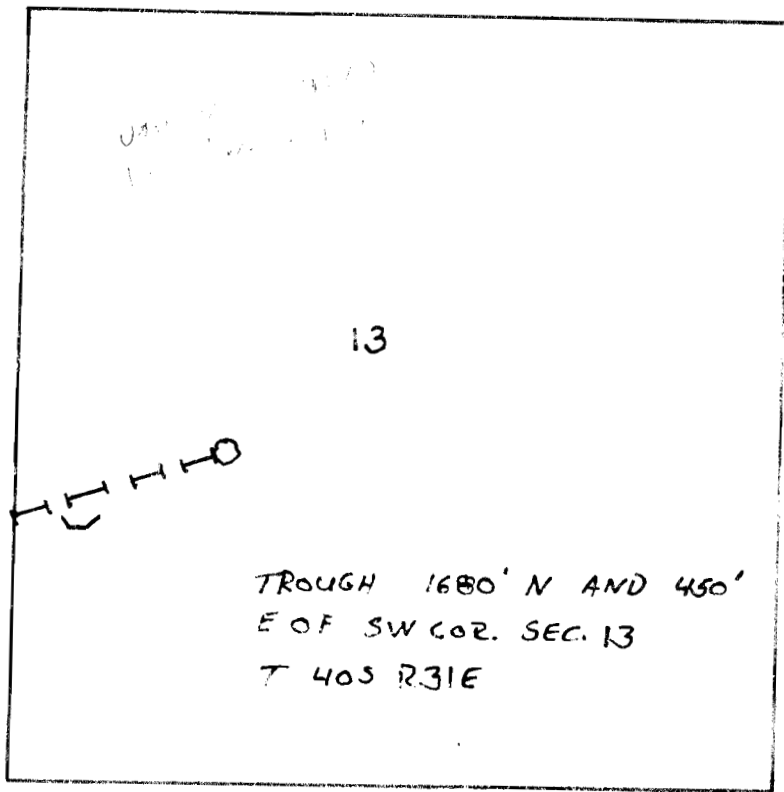

T40S R31E WBM

RECEIVED
JAN 17 1983
WATER RESOURCES DEPT.
SALEM, OREGON

RECEIVED
NOV 15 1982
WATER RESOURCES DEPT.
SALEM, OREGON