


APPLICATION
Application No. # 63278
Permit No. 47301

1

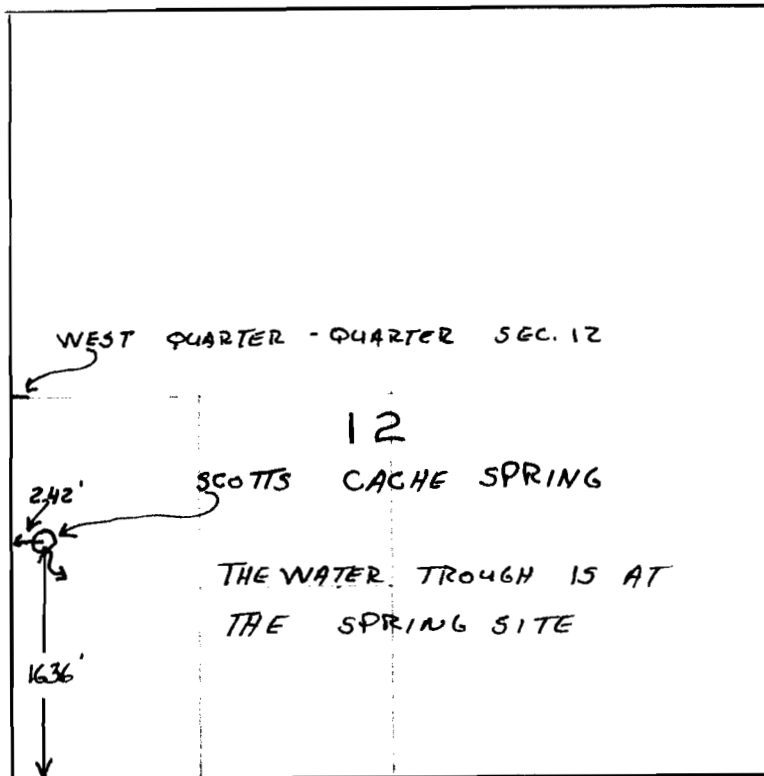

T 40S R 31E W.B.M.

13

RECEIVED

NOV 15 1982
WATER RESOURCES DEPT.
SALEM, OREGON

RECEIVED

JAN 17 1983
WATER RESOURCES DEPT.
SALEM, OREGON