


T. 2 N., R. 5 W., W.M.

Section 26

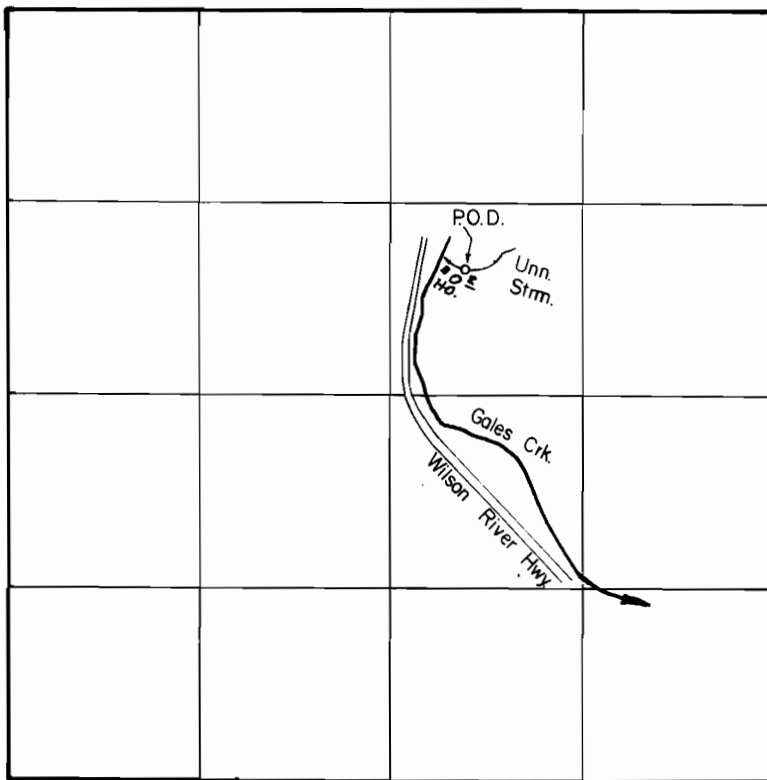

P.O.D. Loc. : 860' N. & 510' E. from C. 1/4 Cor. Sec. 26.

Scale : 1" = 1320'

FINAL PROOF SURVEY UNDER

Application No. 63967. Permit No. 47059
IN NAME OF

GARY O. DAVIS

Surveyed March 30 1988, by T. Warren