


T. 3N., R.3W., W.M.

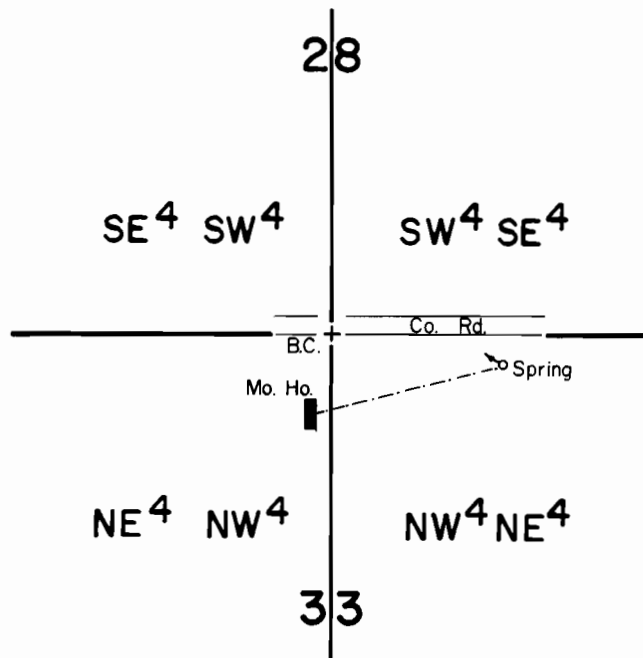

Spring Loc. : 60' S. & 360' E. from N. 1/4 Cor. Sec. 33.

Scale: 1" = 400'

FINAL PROOF SURVEY UNDER

Application No. 64476 Permit No. 47226
IN NAME OF

LYNNETTE JONES

Surveyed May 18 1987, by Ben Bishop