
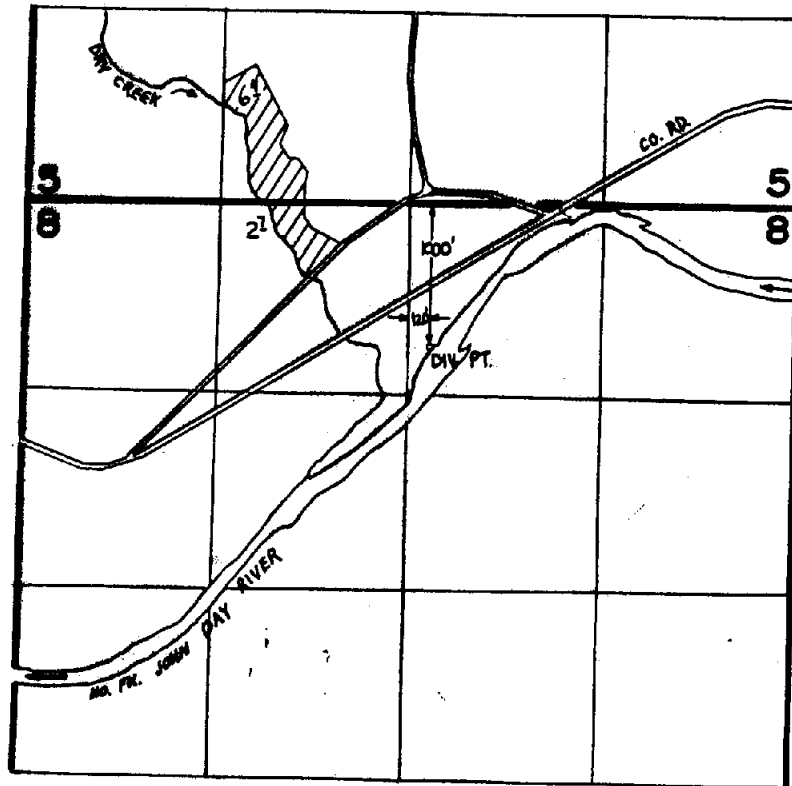


T. 9 S. R. 27 E. W.M.

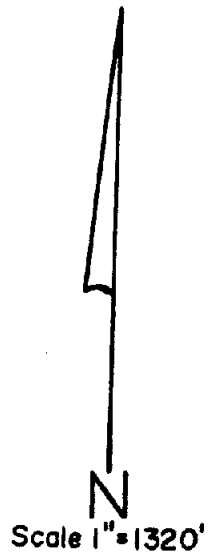

FINAL PROOF SURVEY UNDER

Application No. 64569... Permit No. 47318.....
IN NAME OF

.....**FRANK & MANUEL SILVA**.....

Surveyed March 18 1986, by V. Church.....