

Application No 61841
Permit No 17059

Water Filing For William Huseman
 Located in the S $\frac{1}{2}$ of the S $\frac{1}{2}$ of Section 9, T35S, R14W, W.M. Curry County, Oregon

H. J. Newhouse Surveying
 P.O. Box 176
 Wedderburn, Oregon 97491


FEB 8 1983

REGISTERED
 PROFESSIONAL
 LAND SURVEYOR

H. J. Newhouse

OREGON
 MAY 10, 1957
 H. J. NEWHOUSE
 402

Water System Detail

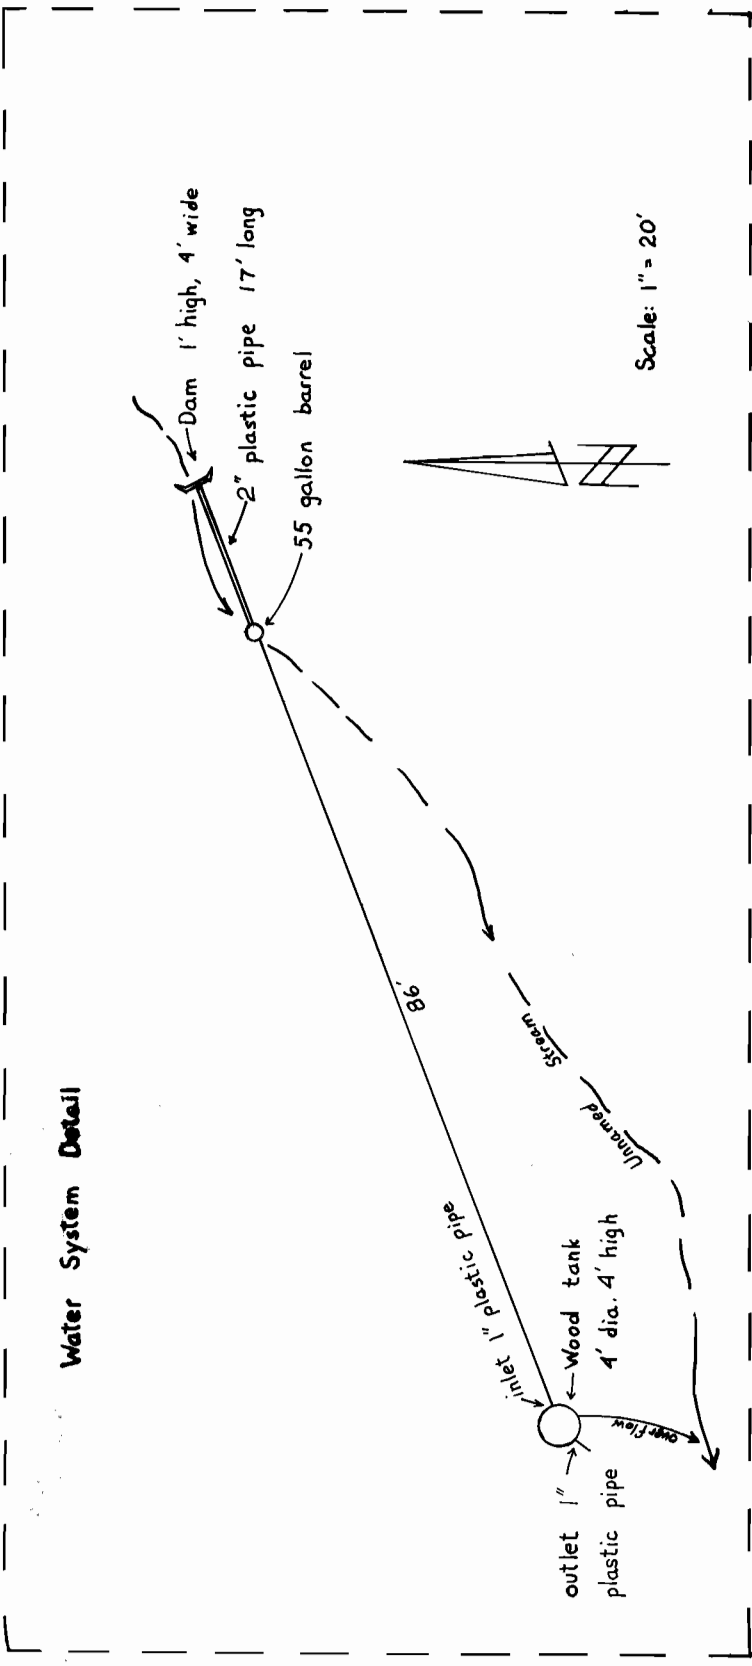

Water Line Location

