


T. 14 S., R. 6 W., W. M.

N

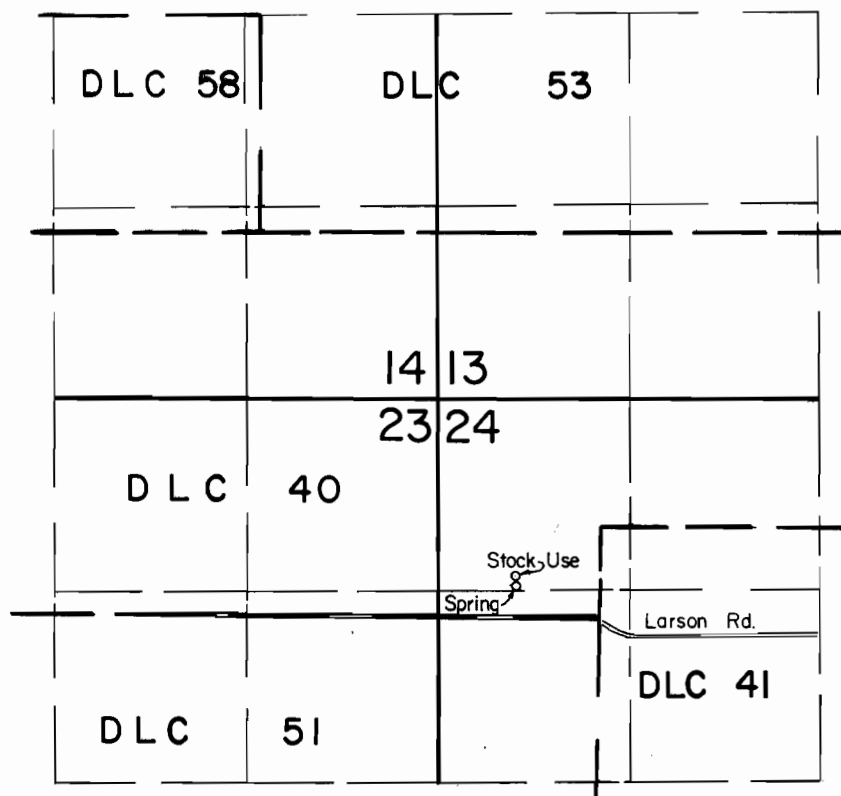

Spring Loc. : 1300' S. & 540' E. from NW Cor. Sec. 24.

Scale : 1" = 1320'

FINAL PROOF SURVEY
UNDER

Application No. 64946 Permit No. 47596
IN NAME OF

GENEVIEVE P. BARHAM

Surveyed Oct. 6 1987, by T. Warren