


T. 14 S., R. 6 W., W. M.

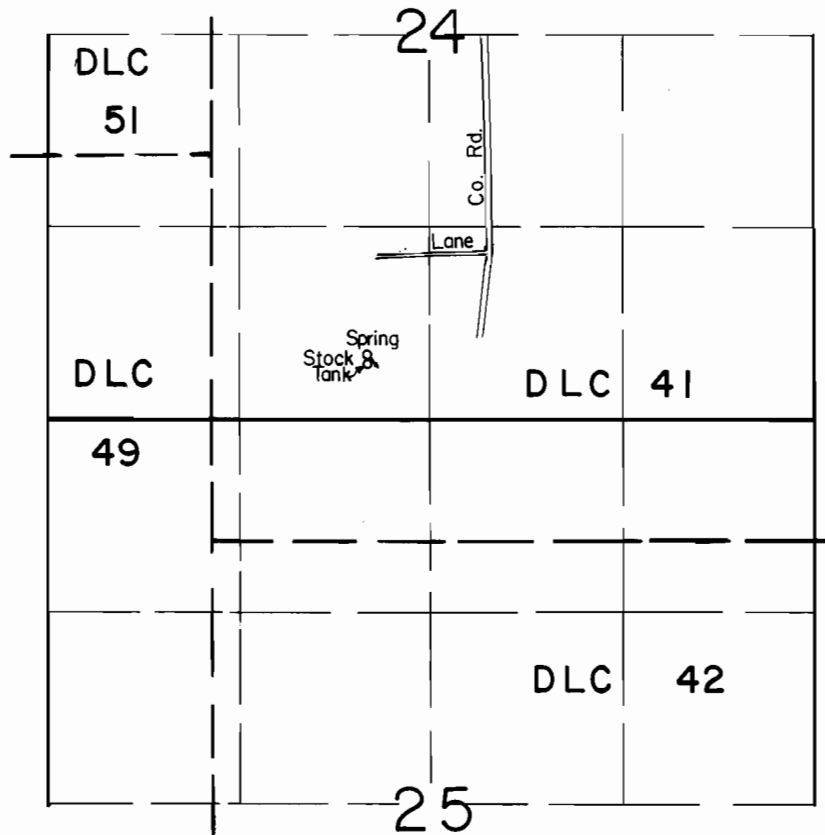

Spring Loc. : 1290' N. & 1070' E. from SW Cor. DLC 41.

Scale : 1" = 1320'

FINAL PROOF SURVEY UNDER

Application No. 65050. Permit No. 47791.....
IN NAME OF

GREGORY E. LOPEZ

Surveyed Oct. 6 1987, by T. Warren.....

DFJ-1LL-64
10/31/88 TMW