


T. 2 & 3N., R. 3W., W.M.

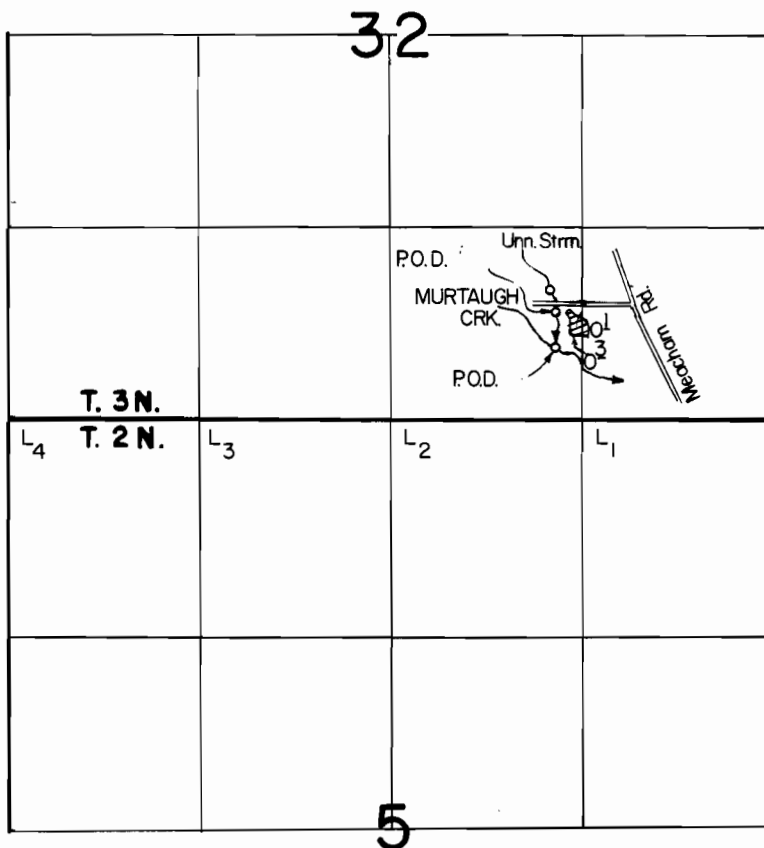

Unn. Strm. P.O.D. Loc. :

580' S. & 180' W.

Murtaugh Creek P.O.D. : 830' S. & 180' W.

All from NE Cor. SW⁴ SE⁴ Sec. 32.

Scale : 1" = 1320'

FINAL PROOF SURVEY

UNDER

Application No. 65082... Permit No. 47567.....
IN NAME OF

BERNARD & LOIS MUNDALL

Surveyed Sept. 1, 1988, by T. Warren