


T. 27 S., R. 6 W., W.M.

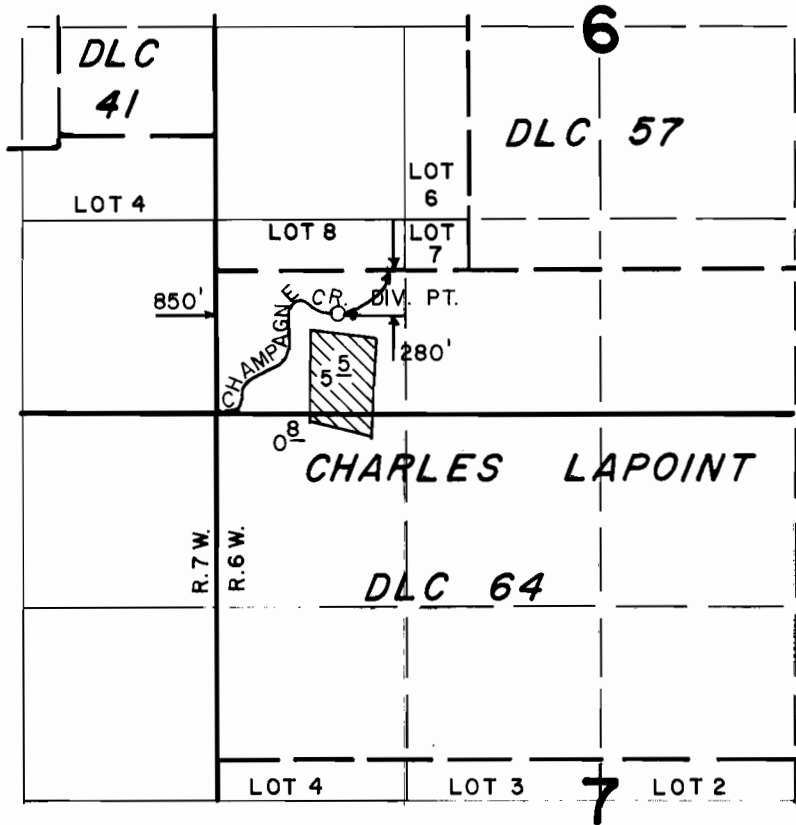

SCALE: 4" = 1 MILE

FINAL PROOF SURVEY UNDER

Application No. 65199 Permit No. 47649
IN NAME OF

RUSSELL E. NOAH

Surveyed OCT. 27, 1987, by J. M. SCHMORDE