


T. 4S., R. 39E., W.M.

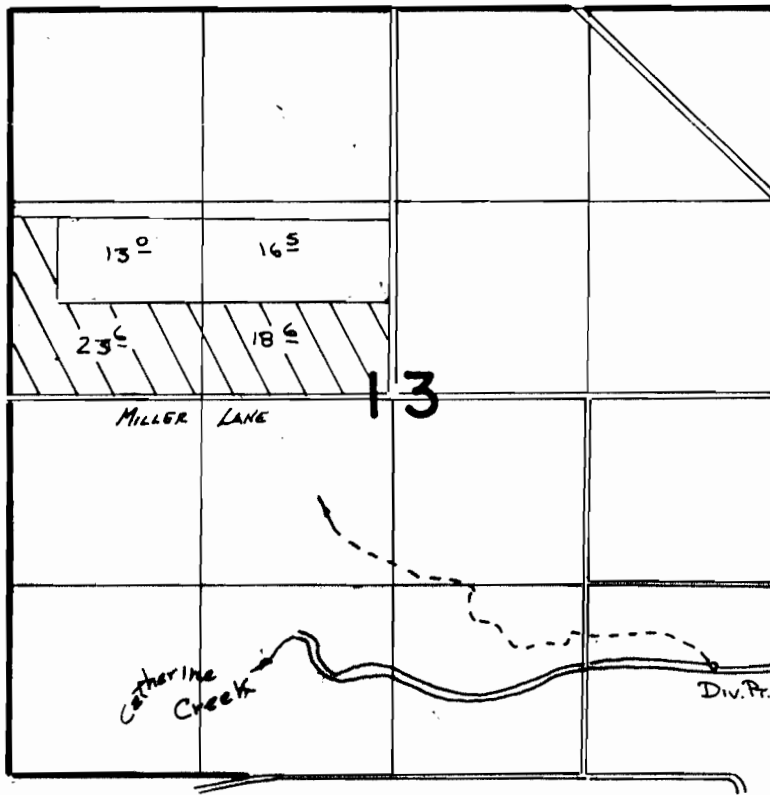

SCALE 1" = 1320'

Div. Pt Loc: 770' N. + 440' W. FROM SE COR.
SEC. 13.

FINAL PROOF SURVEY
UNDER

Application No. **65263** Permit No. **48477**
IN NAME OF

JAMES C. ST. JOHN

Surveyed 9-8-1987, by V.L.C.