


T. 26 S., R. 3 W., W.M.

SECTION 29

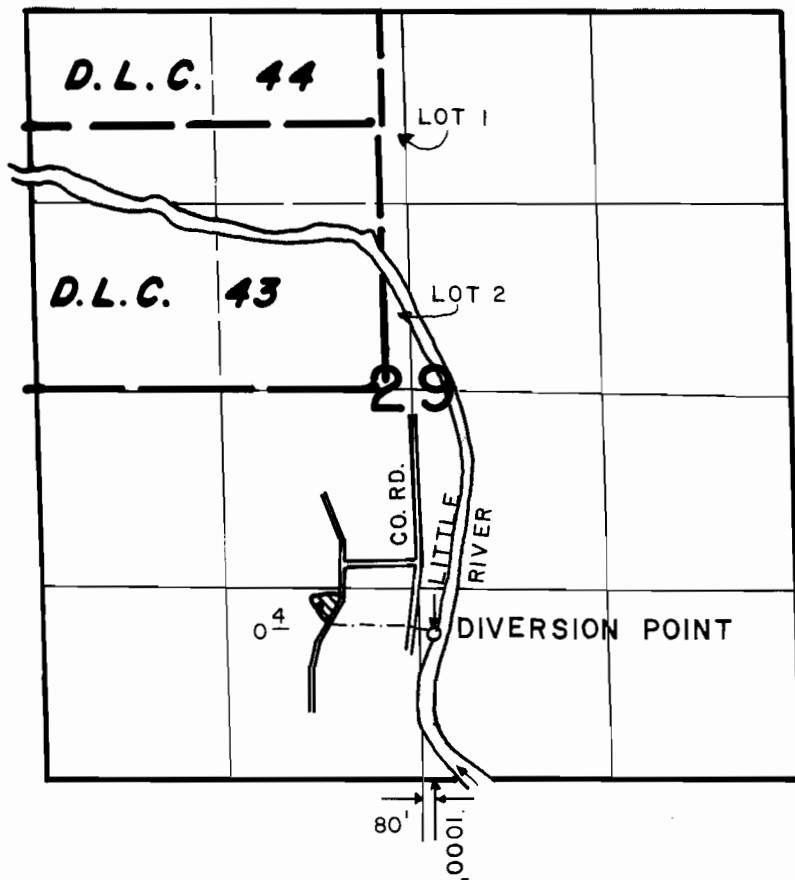

SCALE: 4" = 1 MILE

FINAL PROOF SURVEY UNDER

Application No. 65282 Permit No. 47682
IN NAME OF

CHARLES M. CRESS

Surveyed SEPT. 28, 19.88, by J.M. SCHMORDE