


T. 2 N., R. 2 W., W. M.

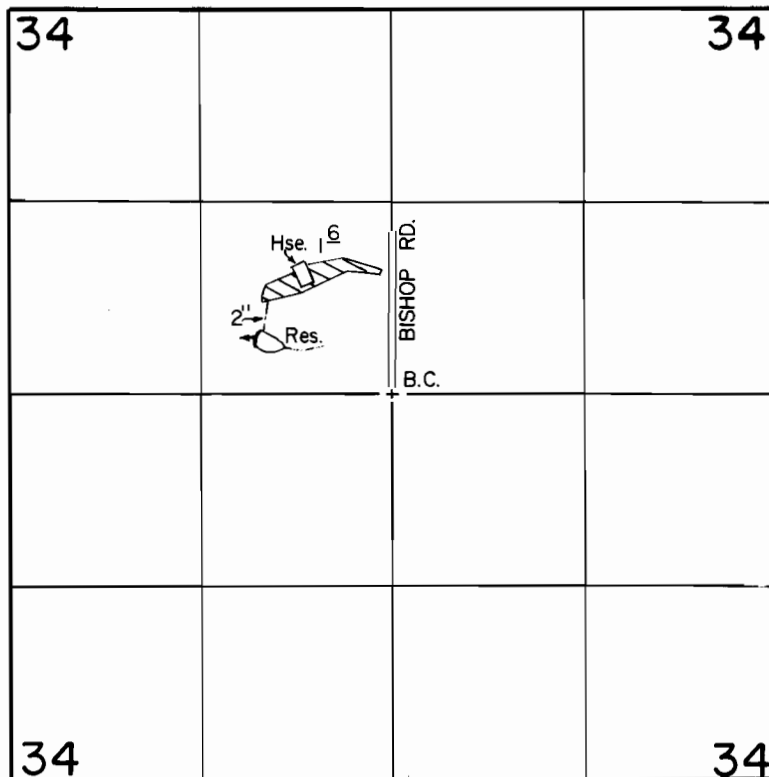

P.O.D. LOC. : 380' N. & 950' W. from C. 1/4 Sec. 34.

Scale : 1" = 1320'

FINAL PROOF SURVEY UNDER

R-64565

R-8607

Application No. 64566. Permit No. 47433.....

IN NAME OF

DAVID R. MALCOLM

Surveyed AUG 31 1988, by T. Warren.....

PTS w/F.F.
11/18/88