


# T. 26S., R. 4W., W.M.

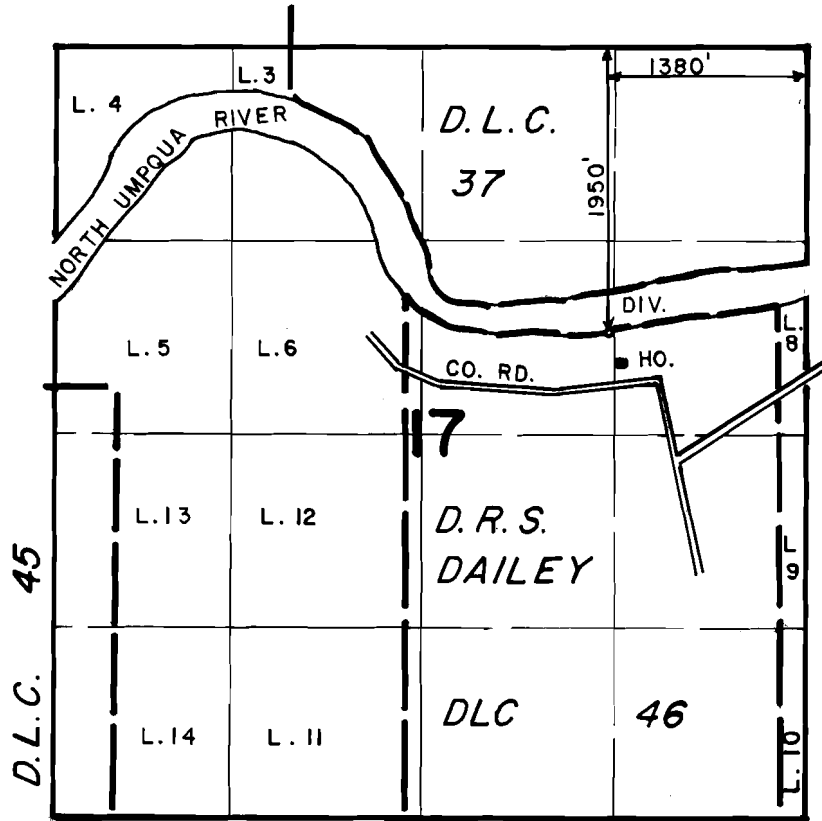

SCALE: 4" = 1 MILE

## FINAL PROOF SURVEY UNDER

Application No. 65594 Permit No. 48003  
IN NAME OF

**EVA V. KRELL**

Surveyed OCT. 29, 1987, by J. M. SCHMORDE